

**ATTACHMENT D – PROCEDURES TO PREVENT HAZARDS**

**PROCEDURES TO PREVENT HAZARDS**

Heritage Environmental Services, LLC  
284 East Storey Road  
Coolidge, AZ 85128

AZD081705402

**TABLE OF CONTENTS**

**1 SECURITY .....4**

**2 INSPECTION SCHEDULE.....5**

**3 EQUIPMENT REQUIREMENTS .....6**

3.1 COMMUNICATION EQUIPMENT ..... 6

3.2 EMERGENCY EQUIPMENT..... 6

3.3 AISLE SPACE REQUIREMENTS ..... 6

3.4 SPRINKLER SUPPRESSION SYSTEM..... 6

    3.4.1 Fire Protection Measures ..... 7

**4 PREVENTIVE PROCEDURES, STRUCTURES, AND EQUIPMENT.....8**

4.1 UNLOADING AND CONSOLIDATION OPERATIONS ..... 8

4.2 RUN-ON / RUN-OFF..... 8

4.3 POWER FAILURE..... 10

    4.3.1 Fire Suppression Capability ..... 10

4.4 PERSONNEL PROTECTIVE EQUIPMENT ..... 10

4.5 MINIMIZE RELEASE TO THE ATMOSPHERE..... 10

4.6 MANAGEMENT OF TEMPERATURE SENSITIVE MATERIALS ..... 10

**5 IGNITABLE, REACTIVE AND INCOMPATIBLE WASTE .....12**

5.1 PREVENTION OF IGNITION OR REACTION..... 12

5.2 GENERAL HANDLING PRECAUTIONS ..... 12

5.3 SCREENING SOLIDS (FILTER CAKE) PRIOR TO BLENDING ..... 12

5.4 MANAGEMENT IN CONTAINERS..... 12

5.5 FIRE DETECTION DEVICES..... 12

**APPENDICES**

Appendix D-A Facility Inspection Information

Appendix D-B Electronic Security Systems (Confidential Business Information)

Appendix D-C Fire Suppression System Diagrams

## 1 SECURITY

A chain link fence with three strands of barbed wire surrounds the facility with the main gate located on Storey Road. The main gate is controlled by restricted electronic key access and can be opened/closed from controls inside the office. A gate for railcar ingress/egress located at the northeast corner of the property is kept locked at all times with a padlock. If the railcar gate is unlocked, Heritage personnel will be present in the vicinity at all times. There is a pedestrian ingress/egress gate located at the southeast corner of the property. It is always kept locked. Keys for the locks are maintained by key employees, and spare keys are stored in the office. An additional access gate on Storey Road, which is normally locked, can be accessed by the City of Coolidge Fire Department. This gate is locked with keys maintained by Heritage employees and the Coolidge Fire Department.

The typical operating hours of the facility are 6:00 A.M. to 5:00 P.M., seven days per week. In the event of an evacuation, facility personnel control access to the facility (see Evacuation Plan in Section 7 of the Contingency Plan).

An automatic gate at the main entrance on Storey Road controls entrance to the facility. Access to the office building is permitted by the front door, into a reception area. Visitors must sign in the logbook and wait for authorized personnel in the reception area. Any on-site visitors are accompanied at all times by Heritage employees. Visitors are required to sign out upon leaving the facility. Contractors must follow Heritage's written program titled "Contractors Safety Guide." Signs are posted at the main entrance, the northeast entrance, and other approachable sides of the facility fence. The signs read "Danger - Unauthorized Personnel Keep Out." The signs are legible from a distance of at least 25 feet. The legend is printed in English and Spanish at the Coolidge facility.

In addition to the security requirements required by 40 CFR Part 264.14(b)(2)(i) and (ii), Heritage provides additional security measures that consist of surveillance cameras that record images at strategic locations within active areas of the facility and other electronic security measures. Additional information concerning the security devices at the facility is provided in Appendix D-B. In lieu of security cameras or similar devices, Heritage may provide 24-hour onsite security personnel.

## 2 INSPECTION SCHEDULE

The following inspection schedule will be implemented:

<i>Reference 40 CFR 264.</i>	<i>Unit</i>	<i>Types of Problems</i>	<i>Minimum Frequency<sup>(1)</sup></i>
15(b)(1)	Safety and emergency equipment <sup>(2)</sup>	Inventory depletion and functionality	Weekly
15(b)(1)	Monitoring equipment <sup>(2)</sup>	Malfunctions and calibration drift	Annual
15(b)(1)	Security devices <sup>(2)</sup>	Malfunctions	Monthly
174	Containment (including trenches and sumps) for container storage areas and bulk loading area (liquids) and concrete base and rail base (for solids storage and bulking)	<ul style="list-style-type: none"> <li>- cracks and gaps in the containment system</li> <li>- wear, cracks, and gaps on berms and walls</li> <li>- wear on sealant</li> <li>- liquids in containment,</li> <li>- waste dropped on containment base</li> <li>- proper placement of grating on containment trenches</li> <li>- Lighting properly functioning (for indoor storage)</li> </ul>	Weekly
174	Containers	<ul style="list-style-type: none"> <li>- Leaking</li> <li>- Bulging</li> <li>- Deterioration</li> <li>- Labeling properly affixed</li> <li>- Containers are closed (except if adding or removing waste)</li> </ul>	Daily
1052	Subpart BB – Pumps	<ul style="list-style-type: none"> <li>- Leaking</li> </ul>	Visual – weekly; Monitor - monthly
1061	Subpart BB – Valves	<ul style="list-style-type: none"> <li>- Leaking</li> </ul>	Initial, then annual
1086 (c), (d), & (e)	Subpart CC – Containers	Cracks, holes, gaps, or other spaces into the interior of the container	Initially, then annual

Notes: <sup>(1)</sup> Changes to inspection frequencies may be made up to the frequency specified in the applicable rules by submitting a Class 1 permit modification request to the ADEQ, in accordance with 40 CFR 270.42.

<sup>(2)</sup> See Table D-A in Appendix D-A for additional details.

The schedule of inspections and the Inspection Reports are maintained by the Environmental Compliance Manager. Specific items that will be inspected are detailed in Appendix D-A. An example Inspection Findings Form that can be used to document inspection dates, corrective actions, and completion dates is also provided in Appendix D-A. Corrective action that is needed, as noted at any inspection, must be initiated within 24 hours and completed as early as possible.

### **3 EQUIPMENT REQUIREMENTS**

#### **3.1 Communication Equipment**

Internal communications and alarm systems used to provide immediate emergency instruction to the facility are discussed in the Evacuation Plan located in Section 7 of the Contingency Plan. Telephones capable of making external calls are located in the office, the laboratory building, and the maintenance building. Emergency telephone numbers are outlined in Section 8 of the Contingency Plan. Employees are equipped with two-way radios or have access to air horns to alert key personnel of an emergency.

#### **3.2 Emergency Equipment**

An emergency equipment list is located in Appendix G-D of the Contingency Plan.

#### **3.3 Aisle Space Requirements**

The facility maintains sufficient aisle space, a minimum of two feet, to allow the unobstructed movement of personnel, fire protection equipment, or spill control equipment to any area of facility in the event of an emergency. For containers that are stored on containment pallets in adjacent rows, the distance between the containers is at least two feet.

#### **3.4 Sprinkler Suppression System**

The Central Container Storage Area and the 800 Container Storage Area are equipped with an automatic fire suppression system that is water-AR-AFFF foam based. The system was designed in accordance with NFPA 30 incorporated into the 2003 International Fire Code which was the standard adopted by the Arizona State Fire Marshal at the time of installation. The fire suppression system installed in the Central Storage Area and the 800 Area Container Storage are suitable for storage of hazardous materials including flammable liquids. In addition to the sprinkler system, the Central Storage Area and the 800 Container Storage Area are equipped with a beam smoke detection system and photoionization smoke detection system as a means to detect fire/smoke in advance of sprinkler system activation and provide early warning to emergency responders. Appendix D-C provides drawings of the fire suppression and alarm system.

There are also several water outlets within the facility that may be utilized in an emergency. There are eight water storage tanks at the facility that are filled by groundwater from an on-site water production well that is designed to pump ground water in excess of 600 gallons per minute. The tanks are equipped with low-level alarms. Heritage controls water rights for the aquifer beneath the facility, and water usage is well below the volume of water rights. In addition to the sprinkler suppression system, the Heritage facility is protected by conventional ABC fire extinguishers. There are also 55-gallon containers of AFFF fire suppression foam available for response to a fire. Heritage personnel have been trained in fire response by the local fire department.

### 3.4.1 Fire Protection Measures

Heritage maintains the following measures for fire protection:

1. Heritage has a fire suppression system serving the Central Container Storage Area and the 800 Area Container Storage Area at the facility. This system is maintained in operational status.
2. Heritage has an existing system of water storage tanks at the facility that are filled by a groundwater production well. The current volume of water in storage exceeds 126,900 gallons. The pumps and water tank systems are maintained in operational status. The water well is designed to pump ground water at a rate in excess of 600 gallons per minute to replenish water storage tanks in the event of an emergency.
3. Heritage maintains its water rights, sufficient to provide adequate volume of water to the water storage tank system. Heritage has not sold or traded any of its water rights for the facility.
4. The Heritage facility is also served by the City of Coolidge Fire Department. The City of Coolidge has informed Heritage of additional equipment purchases that enable even more sophisticated response to emergencies at the Heritage facility. The advanced equipment ordered by the City of Coolidge reduced the quantity of water necessary for fire-fighting, in comparison to existing equipment and technology.
5. The City of Coolidge has in place a written Mutual Aid Agreement with the following municipal fire departments within Pinal County:
  - Casa Grande Fire Department
  - Eloy Fire Department
  - Maricopa Fire Department
  - Arizona City Fire District
  - Avra Valley Fire District
  - Florence Fire Department
  - Golder Ranch Fire District
  - Kearny Fire Department
  - Stanfield Fire Department
  - Regional Fire & Rescue Department
  - Gila River Indian Community Fire Department
6. Heritage has four 55-gallon canisters of AFFF fire suppression foam in inventory. The canisters are stored outside the southwest corner of the Central Container Storage Area. As part of the Agreement with the City of Coolidge, the Coolidge Fire Department owns and will provide the foam eductors necessary for application of the AFFF foam on-site at Heritage, should it be required in an emergency.
7. In addition to hand-held A/B/C fire extinguishers, Heritage has two 125-pound fire extinguishers rated B/C for flammable liquid and electrical fires (both located at the Central Container Storage Area) and two Class D fire extinguishers (one located in the Lab Depack Area and one located in Area 800 by the north door).

8. Heritage employees have been trained in the use of Fire Extinguishers.
9. Heritage employees have been trained in the Contingency Plan and Procedures to Prevent Hazards documents established for emergencies at the facility.
10. Heritage has established "No Smoking" areas and appropriate signage. Heritage also has a "Safe Work Permit" program that would prevent performance of any "hot work," such as welding in the areas where hazardous wastes are stored, without the proper precautions (e.g., relocation of combustible materials).

#### 4 PREVENTIVE PROCEDURES, STRUCTURES, AND EQUIPMENT

##### 4.1 Unloading and Consolidation Operations

Unloading procedures for containerized wastes are discussed in the Container Storage and Consolidation Plan (Section D). Container loading and unloading is conducted with specialized equipment designed to move containers in accordance with written Standard Operating Procedures (SOPs). Consolidation operations, including solids (filter cake) blending, is conducted with specialized equipment in accordance with written SOPs. Consolidation equipment, including housekeeping tools, is tested and maintained and inspected prior to use.

The following SOP's related to bulking, blending, and consolidation will be maintained at the facility:

- F006 Blending and Consolidation
- Organic Waste Consolidation
- Bulking for Shipment Offsite

##### 4.2 Run-on / Run-off

All hazardous waste activities are conducted indoors, under roof with curbing, or in otherwise contained areas. The facility has the following controls to prevent run-on/runoff of storm water.

**General Facility Controls:** The facility has a soil berm constructed on the north, east and west side of the perimeter fence with the exception of areas where access is required (e.g., the rail spur). These berms mitigate potential run-on and run-off from the facility. Based on visual observation, drainage conveyances are constructed along the railroad and along East Storey Road to prevent run-on to the facility from potential offsite sources.

**Central Storage Area** – The Central Storage Area is constructed of poured concrete walls up to approximately 4 feet above the surrounding grade. Above the concrete wall, the Central Storage Area is a metal-sided building with a roof to prevent precipitation from entering the Central Storage Area. These structures serve to mitigate any potential run-on into the unit and prevent precipitation from accumulating. Although located in an indoor structure under roof, the sloped floors coupled with blind sumps of the Central Storage Area would serve to prevent run-off from the unit.

**Roll Off Container Storage Area** – The Roll-Off Container Storage Area is a contained area that consists of block walls on the east and north sides of the unit that are approximately



eight feet in height. On the south side of the unit, a six-inch concrete curb is present at the Roll-Off Container Storage Area. On the west side of the unit, a 3-inch curb is present at the Roll-Off Container Storage Area. The structures are constructed in a manner that they are sufficiently above the surrounding grade to prevent run-on/run off at the unit. Additional detail concerning the construction of the curbs is provided in Section D of the permit application.

**Dock and Van Container Storage Area (DVSA)** – The DVSA secondary containment volume is sufficient to contain precipitation from a 25-year/24-hour storm event including any run-on into the unit which was based on land surveying conducted to determine the drainage area in the vicinity of the DVSA. Section D of the permit application provides additional information.

**East Container Storage Area** – Run-on Run-off is prevented in the East Container Storage Area by curbing that is a minimum of 5.5 inches above the surrounding grade to prevent run-on/run-off from the unit.

**Lab Depack Area** – The Lab Depack Area is located inside a building with a roof and doors to prevent precipitation and runoff from the unit. The finished floor of the unit is above natural grade and the unit is accessed by a concrete ramp which mitigates the potential for run-on at the unit. Storage of hazardous waste in the Lab Depack area is conducted in Portable Secondary Containment Pallets. These manufactured devices are typically constructed with sides of sufficient height to prevent contact from run-on/run-off at the unit. Section D, Appendix D-H provides technical information for typical secondary containment pallets.

**Bulk Loading Area (Tanker and Rail)** – The Bulk Loading Area (Tanker and Rail) secondary containment volume is sufficient to contain precipitation from a 25-year/24-hour storm event, including any run-on into the unit, based on land surveying conducted to determine the drainage area in the vicinity of the adjacent DVSA. Accumulated precipitation or other liquids found in the containment are removed within one operating day of discovery. Section D, Appendix D-E provides additional information.

Metal grates over the sump minimize run-on into the sump. To the west of the rail spur, there is an 18-inch-high wall to minimize run-on into the unit. Where there is a gap in the wall and grating over additional containment for the rail area, that grating is raised, preventing run-on into the unit from the dock area. To the south of the rail spur, there is an end-loading dock for railcars. This dock is raised and sloped away from the rail area, preventing run-on or run-off. The tanker truck bay is sloped from the south and from the north toward the sump to minimize run-off from the area. To the east of the tanker truck bay, the unit is bordered by walls. Therefore, there is no run-on or run-off at the east side of the unit.

**800 Area Container Storage** – The 800 Container Storage Area is located inside a building with roof and doors to prevent precipitation and significantly limit the potential for run-off or accumulated precipitation. Storage of hazardous waste in the 800 Area Container Storage is conducted in Portable Secondary Containment devices. These manufactured devices are typically constructed with sides of sufficient height to prevent contact with hazardous waste from potential run-on/run-off. Section D, Appendix D-H provides technical information for typical secondary containment pallets.

#### 4.3 Power Failure

In the case of a power failure, the facility may have to cease operations, but there would be no threat of a release or endangerment to human health or the environment. Ingress/egress to the facility would be via the manually controlled gates or the main gate, which can also be manually opened. A list of emergency lighting units is included with the emergency equipment list in Appendix G-D of the Contingency Plan.

##### 4.3.1 *Fire Suppression Capability*

The fire suppression system in the Central Storage Area and the 800 Area Container Storage Area is equipped with a rated fire pump powered by a diesel engine. The diesel fire pump is designed to operate with or without power either automatically or in manual mode.

In the event of a power outage during a fire, the fire hydrant feed pump system will not operate because there is no backup power source. The fire department has access to the fire water supply through the hydrants (the City of Coolidge pumper trucks have the capability to suck water from hydrants) as well as from a central draw-point. The pumper trucks will then boost the pressure for direct fire-fighting purposes.

The well pump will also not operate when the power is out and will not be able to refill the water tanks. In this case, the facility will be limited to the stored volume of water (126,900 gallons) at the facility before water from offsite is required. The Coolidge Fire Department is in the process of acquiring new equipment that will significantly reduce the water requirements of their pumper trucks.

The loss of power will have no effect on the use of the four foam canisters, as these are educted by the fire trucks. Also, the loss of power will have no effect on using hand-held extinguishers.

#### 4.4 Personnel Protective Equipment

The facility prevents undue exposure of personnel to hazardous waste by installing engineering controls, implementing administrative measures, or providing employees with the appropriate personal protective equipment. Heritage provides eye protection (e.g., safety glasses), foot protection (steel-toed boots), dermal protection (coverall, gloves, aprons, uniform, etc.), and breathing protection (e.g., air purifying respirator) which is selected based on the task or activity being performed and the conditions associated with the task being performed. In addition, Heritage provides thorough medical monitoring for employees. The medical monitoring program is managed by an industrial hygienist and Heritage occupational health physicians.

#### 4.5 Minimize Release to the Atmosphere

Waste management activities are conducted in a manner to minimize the exposure to the atmosphere by engineering controls and by conducting activities under roof, when possible. Solids (filter cake) blending operations do not take place in windy conditions. If deterioration or leaks are detected during container inspections, the container is immediately overpacked.

#### 4.6 Management of Temperature Sensitive Materials

Heritage prohibits certain wastestreams that are considered temperature sensitive from being accepted at the facility during the months of June through September when average

daily high temperatures in the Phoenix area exceed 100° F. Wastestreams that generators identify as temperature sensitive, shock sensitive, spontaneously combustible, or requiring temperature controls undergo an additional technical review prior to approval to consider whether or not the materials can be accepted at the facility during the months of June through September.

Wastes that will normally be prohibited from acceptance to the facility during months of June through September will consist of the following:

- Wastestreams that generators identify on the Heritage wastestream profile as being temperature sensitive, requiring temperature controls, or are shock sensitive with self-accelerating decomposition temperatures that are less than 122° F (50° C). Typically, these materials are azo-compounds, azide-compounds, and organic peroxides.
- Technical/commercial grade formulations of the following compounds or formulations:

dibenzyl peroxydicarbonate	hexanite	picryl fluoride
2,5 dimethyl-2,5-dihydroperoxy hexane	hexanitrodiphenylamine	polynitro aliphatic compounds
dinitrotoluene	hexanitrostilbene	potassium
dry guanyl compounds	hexogen	nitroaminotetrazole
dry lead azide	hydrazoic acid	robenzoic acid
Unwetted nitrocellulose films and similar materials	hyrazinium nitrate	silver acetylde
Unwetted picric acids	lead azide	silver azide
Unwetted explosives	lead mannite	silver fulminate
aluminum ophorite explosive	lead	silver styphnate
amatol	mononitroresorcinat	silver tetrazene
ammonal	lead picrate	sodatol
butyl tetryl	lead styphnate	sodium amatol
copper acetylde	magnesium ophorite	syphnic acid
cyanuric triazide	mannitol hexanitate	tetranitrocarbazole
cyclotrimethylenetrinitramine	mercury fulminate	tetraze
e	mercury oxalate	tetrytol
dinitroethyleneurea	mercury oxalate	trimethylolethane
dinitroglycerine	mercury tartrate	trimonite
dipicryl sulfone	mononitrotoluene	trinit
dipicrylamine	nitrated carbohydrate	trinitroanisole
erythritol tetranitrate	nitrated glucoside	trinitrobenzoic acid
fulminating gold	nitrated polyhydric alcohol	trinitrocresol
fulminating mercury	nitrogen trichloride	trinitro-meta-cresol
fulminating platinum	nitrogen triiodide	trinitronaphthalene
fulminating silver	nitroglycide	trinitrophenetol
gelatinized nitrocellulose	nitroglycol	trinitrophenol
guanyl nitrosamino	nitronium perchlorate	trinitrophenol
guanyl nitrosamino	nitrourea	trinitroresorcinol
guanylidene	organic amine nitrates	urea ammonium nitrate
guanyltetrazene	organic nitramines	vinyl chloride
heavy metal azide	picramide	vinylidene chloride
	picratol	acetylides

## 5 **IGNITABLE, REACTIVE AND INCOMPATIBLE WASTE**

### 5.1 Prevention of Ignition or Reaction

Smoking is allowed in designated areas only. "NO SMOKING" signs are posted throughout the facility. Any work that involves open flames or other sources of heat (*e.g.*, welding, cutting, etc.) must be accompanied by a Heritage-issued Safe Work Permit. Water reactive wastes will only be stored in the Lab Depack Area. When water reactive wastes are in transit on a trailer, the trailer will be placarded accordingly.

### 5.2 General Handling Precautions

The procedures to be followed prior to consolidating different wastestreams are specified in the facility's Waste Analysis Plan (Section C) and in facility SOPs.

### 5.3 Screening Solids (Filter Cake) Prior to Blending

Wastestreams designated for the Solids (Filter Cake) Blending program are initially screened for cyanide, volatile organic compounds, and free liquids. Additional details are provided in the Waste Analysis Plan (Section C).

### 5.4 Management in Containers

Containers of ignitable or reactive waste are located at least 50 feet (15 meters) from the facility's property line. See the Container Storage and Consolidation Plan (Permit Section D) for applicable drawings. Incompatible wastes and materials are not placed in the same container or in unrinsed containers that previously held incompatible wastes. Incompatible materials will not be stored in a railcar and a tanker truck simultaneously in the Bulk Loading Area. Storage of incompatible containers is addressed in the Container Storage and Consolidation Plan (Section D).

### 5.5 Fire Detection Devices

The facility is equipped with automated fire detection devices in the Central Container Storage Area, the 800 Area Container Storage Area, the Dock and Van Container Storage Area, and the Rail and Tanker Loading Area, as well as other areas of the facility. Depending on their location, these automated devices are designed to detect a pressure loss indicating that automated fire suppression equipment was engaged, detect heat in excess of 190° F, detect smoke using beam detection systems, or detect smoke by photoionization devices. Manual pull-down fire alarms are also present at the facility. When engaged, these devices activate internal horns/strobe lights and automatically notify a third-party alarm-monitoring company. Additional information is provided in Appendix D-B.

**APPENDIX D-A**  
**FACILITY INSPECTION INFORMATION**

### **CONTAINER AND CONTAINMENT INSPECTION**

Containers will be inspected for leaks, deterioration, and presence of labeling on a daily basis. The frequency of inspection for the structure and ancillary items in the container storage areas, [e.g., containment system, trenches, and sumps (for liquids), and concrete base, berms and walls (for Hazardous roll-off storage)], will be weekly. Additional information is available in Section 2 – Inspection Schedule and in the Container Storage and Consolidation Plan (Section D).

### **SAFETY AND EMERGENCY EQUIPMENT INSPECTION**

At a minimum frequency of once per week, emergency equipment identified in the Contingency Plan will be inspected to identify that the items are present and in working order. In addition, safety equipment identified in Table G-A will be inspected at the frequency noted in Table G-A.

### **MONTHLY SECURITY INSPECTION**

At a minimum frequency of once per month, the following security items will be checked:

- Fencing in good condition
- Fence-line berms in good condition (i.e., sufficient sandy clay loam content for structural integrity to prevent stormwater run-on/run-off) with minimum height of 1.5 feet  
\* (in addition to monthly, check integrity after any storm event greater than 1 inch)
- Danger signs posted
- Automatic gates operational

### **ANNUAL SAFETY MONITORING EQUIPMENT/ COATING/ SPRINKLER INSPECTION**

At a minimum frequency of once per year, Heritage will inspect monitoring equipment for malfunction or calibration drift.

At a minimum frequency of once per year, the coatings will be inspected for cracks, spalling, blistering, chips, or staining (only an indicator).

At a minimum frequency of once per year, the fire suppression systems at the Central Container Storage Area and the 800 Storage Area will be inspected to confirm that they are in working order. The components that will be inspected include the automatic sprinkler systems, the pumping systems that feeds the sprinkler system, and the fire hydrants. The pressure gauges will be inspected for malfunction or calibration drift.

### **SUBPART BB INSPECTION AND REPAIRS**

Refer to Subpart BB Air Emissions Standards for Equipment Leaks (Section N) for more information. At a minimum frequency of once per week, the following equipment will be inspected:

- Pumps in light liquid service will be inspected in accordance with 40 CFR 264.1052
- Flanges and other connectors will be inspected in accordance with 40 CFR 264.1058
- Heritage has opted to monitor valves in light liquid services per 40 CFR 264.1061
- Monitoring shall comply with 40 CFR 264.1063(b)
- All repairs will be in compliance with 40 CFR 264 Subpart BB

### **SUBPART CC INSPECTION**

At a minimum, containers will be visually inspected for cracks, holes, gaps, or other spaces into the interior of the container as required in 40 CFR Part 264, Subpart CC. Refer to the Subpart CC Inspection and Monitoring Plan (Section O) for more information.

- If waste is added to a container at the facility, the initial inspection must be performed promptly upon adding waste to the container.
- If waste is already in the container, the initial inspection must be performed at the time the container is being accepted at the facility.
- If a container remains at the facility for a period of one year or more, the visual inspection must be repeated once every 12 months.

### **CHECKLISTS**

Heritage maintains checklists documenting inspections of each area subject to daily, weekly, monthly, and annual inspections. Samples of these checklists are provided in the following pages. An entry will be made on the relevant checklist for each item subject to inspection and will include the printed name and signature of the inspector and the date of the inspection.

**Table D-A**  
**Safety and Security Equipment<sup>(1)</sup>**  
**Heritage Environmental Services, LLC**  
**Coolidge, AZ**

Equipment	Location	Manufacturer	Model Number	Inspection Frequency <sup>(2)</sup>	Comment
Phones	Offices	AT&T	2-line speaker phones model 993	Daily	
Paging System	Front Office and Warehouse Breakroom	ADT/Cortelco	C-123LW LEM	Daily	Speakers in 600, Dock, 300, Scalehouse and Warehouse
Radios	With Each Staff Member	Nextel	Varies	Daily	
Air Horn	Emergency Equipment Cabinet	Falcon Signal Horns	Varies	Weekly	
Surveillance Cameras	Recording Unit in Scalehouse	ADT \ GE	DIVAR Digital Versatile Recorder	Daily	Locations throughout the facility
Auto Dialer	Scalehouse	ADT	control panel - model Vista 50P	Annual	
Fire Suppression System					
Tanks	South side of property near Central Storage Area at Pumphouse	N/A	N/A	Daily	
Diesel Fire Pump	South side of property near Central Storage Area at Pumphouse	Aurora Pump/Cummins Diesel	Model 4-491-14C/CFP39-F15	Annual	System inspection
Pump Controller	Pumphouse on south side of property near Central Storage Area	Metron	FD4	Annual	System inspection
Sprinkler System	Central Storage Area and 800 Storage Area	Varies	Varies	Annual	System inspection
Foam System	South side of 600 Building adjacent to main feed riser	Ansul AR-AFFF System	Varies	Annual	System inspection
Alarms/Monitors	Throughout Central Storage Area and 800 Storage Area	Varies	Varies	Annual	System inspection
Heat detection cable	Dock and Van Container Storage Area & Bulk Loading / Unloading Area	Safe Fire Detection, Inc.	Thermo Cable	NA	Does not require inspection, in the event that the signal becomes disconnected the fire alarm will sound
Horn / strobe lights	Dock and Van Container Storage Area, Central Storage Area, 800 Area Storage	System Sensor	SpectrAlert Advance	Annual	System inspection
Pull alarms	Outside 800, Central Storage Area, 800 Area Storage, and inside main office	Varies	Varies	Annual	System inspection
Smoke alarms	Main office and Scaleroom	Varies	Varies	Annual	System inspection
Photoionization Smoke alarms	Central Storage Area and 800 Storage Area	Fenwall		Annual	System inspection
Beam smoke detection system	Central Storage Area and 800 Storage Area	Xtralis	OSID	Annual	System inspection
Fire hydrants	South of 600 at fence and East of 300 at fence			Annual	
Fire extinguishers - hand held	Throughout the facility	Badger Fire Protection	Varies	Weekly	
Fire extinguishers - wheeled	Noth side of Central Storage Area, Outside SE corner of Central Storage Area	Badger Fire Protection	Badger 150	Weekly	
Foam canisters	4 55-gal drums, stored on N side of 800 Building			Monthly	
Automatic gate	South Fence on Property	Controls from ADT	Brivo System	Monthly	

Notes:

(1) New or updated equipment may be purchased and installed as it becomes available. Equipment may be replaced with functionally equivalent equipment

(2) Heritage established inspection frequency. Changes to inspection frequencies may be made up to the frequency specified in the applicable rules by submitting a Class 1 Permit Modification to ADEQ, in accordance with 40 CFR Part 270.42.



Heritage Environmental Services, LLC

Daily Inspection Findings Form

Item:  
Paging System

Date:

Name:

Page:

Finding		Corrective Action or Scheduled Date for Correction	Completed (Signature, Printed Name, Date)
	M		By:
	H		Date:
	M		By:
	H		Date:
EXAMPLE FORM

M = Maintenance

H = Housekeeping

**Heritage Environmental Services, LLC**

**Weekly Inspection Findings Form**

**Item:**  
**Fire Extinguishers -**  
**Hand Held**

**Week of:**

**Name:**

**Page:**

Finding		Corrective Action or Scheduled Date for Correction	Completed (Signature, Printed Name, Date)
	M		By:
	H		Date:
	M		By:
	H		Date:
**EXAMPLE FORM**

M = Maintenance

H = Housekeeping

Heritage Environmental Services, LLC

Annual Inspection Findings Form

Item:  
Fire Hydrants

Year:

Name:

Page:

Finding		Corrective Action or Scheduled Date for Correction	Completed (Signature, Printed Name, Date)
	M		By:
	H		Date:
	M		By:
	H		Date:
EXAMPLE FORM

M = Maintenance

H = Housekeeping



Heritage Environmental Services, LLC

Tank Car Inspection Checklist – Upon Arrival - Full  
(from SOP #HS-49 Railcar Operations)

E  
X  
A  
M  
P  
L  
E  
F  
O  
R  
M

Heritage Railcar Inspection - Prior to unloading inspection  
Tank Car Inspection Checklist - Upon Arrival - Full

Date: \_\_\_\_\_ Tank Car No. \_\_\_\_\_

Contents: \_\_\_\_\_

Inspector: \_\_\_\_\_ Unloader: \_\_\_\_\_ Doc #: \_\_\_\_\_

Inspector's initials

1. Blue "Caution Men At Work" Sign on Track \_\_\_\_\_
2. Hand brake set, wheels chocked, derail set \_\_\_\_\_
3. Tank car bonded an/or grounded (if applicable) \_\_\_\_\_
4. Placards on all four sides \_\_\_\_\_
5. All valve closed with no leaks prior to opening \_\_\_\_\_
6. Examine all fittings, seals, and gaskets \_\_\_\_\_
7. Exterior condition of tank \_\_\_\_\_
8. Mechanical integrity of car (visual inspection) \_\_\_\_\_
9. Railcar exhibits no sign of leaking \_\_\_\_\_
10. Belly valve is securely closed \_\_\_\_\_
11. All handrails are good condition \_\_\_\_\_

Comments/Problems Noted:

If Railcar has a problem or defect requiring corrective action please explain below.  
(include actions taken to correct issue, corrected by, supervisor initial, and date corrected)

Signature \_\_\_\_\_

Inspection date \_\_\_\_\_



**Heritage Environmental Services, LLC**

**Tank Car Inspection Checklist – Outboard Railcar  
 (from SOP #HS-49 Railcar Operations)**

E  
X  
A  
M  
P  
L  
E  
F  
O  
R  
M

**Tank Car Inspection Checklist – Outbound Railcar**

Date: \_\_\_\_\_ Tank Car No. \_\_\_\_\_ Prior Contents: \_\_\_\_\_

Seal #(s): \_\_\_\_\_

		Initial Below	
		Inspector 1	Inspector 2
1	Within maximum load limit		
2	Correct outage observed		
3	Valves with lock pins are closed and secure		
4	All unloading connections/hose/fittings are removed		
5	Bottom outlet cap tightened and secured with a 3/6" wrench		
6	Steam coil inlet and outlet caps are hanging (if applicable)		
7	Manway gasket is in good condition, replace if necessary		
8	Manway cover is closed on seated gasket, and security seal is in place		
9	Manway bolts tightened with wrench using star pattern (torque tight)		
10	Under protective housing, valves are closed and plugs/caps/nuts wrench tight		
11	Safety relief vent / valve checked (replace frangible disk if needed)		
12	Protective housing is secured in place with lock pin and security seal		
13	All four sides are properly placarded and stenciling legible		
14	All non-DOT placards / markings (i.e. used oil) removed		
15	All tank car safety / inspection test dates are current		
16	Grounding / Bonding devices removed		
17	Under frame checked for wear plates, springs, loose equipment, railings, etc		
18	Exterior is clean and free of spills or residue		

**The checks and blue "Caution" sign should not be removed until the railcar is ready for pick-up.**

Inspector 1 from above: Printed Name: \_\_\_\_\_ Signature: \_\_\_\_\_

Inspector 2 from above: Printed Name: \_\_\_\_\_ Signature: \_\_\_\_\_

\*If Railcar has a problem or defect requiring corrective action please explain below;  
 (include actions taken in correct issue, corrected by, supervisor initial, and date corrected)

Supervisor's Signature \_\_\_\_\_ Date \_\_\_\_\_


Appendix B – Tank Car – General Information

**APPENDIX D-C**

**FIRE SUPPRESSION SYSTEM DIAGRAMS**



**AS-BUILT PUMP, AR-AFFF FOAM, AND PIPING SYSTEM**


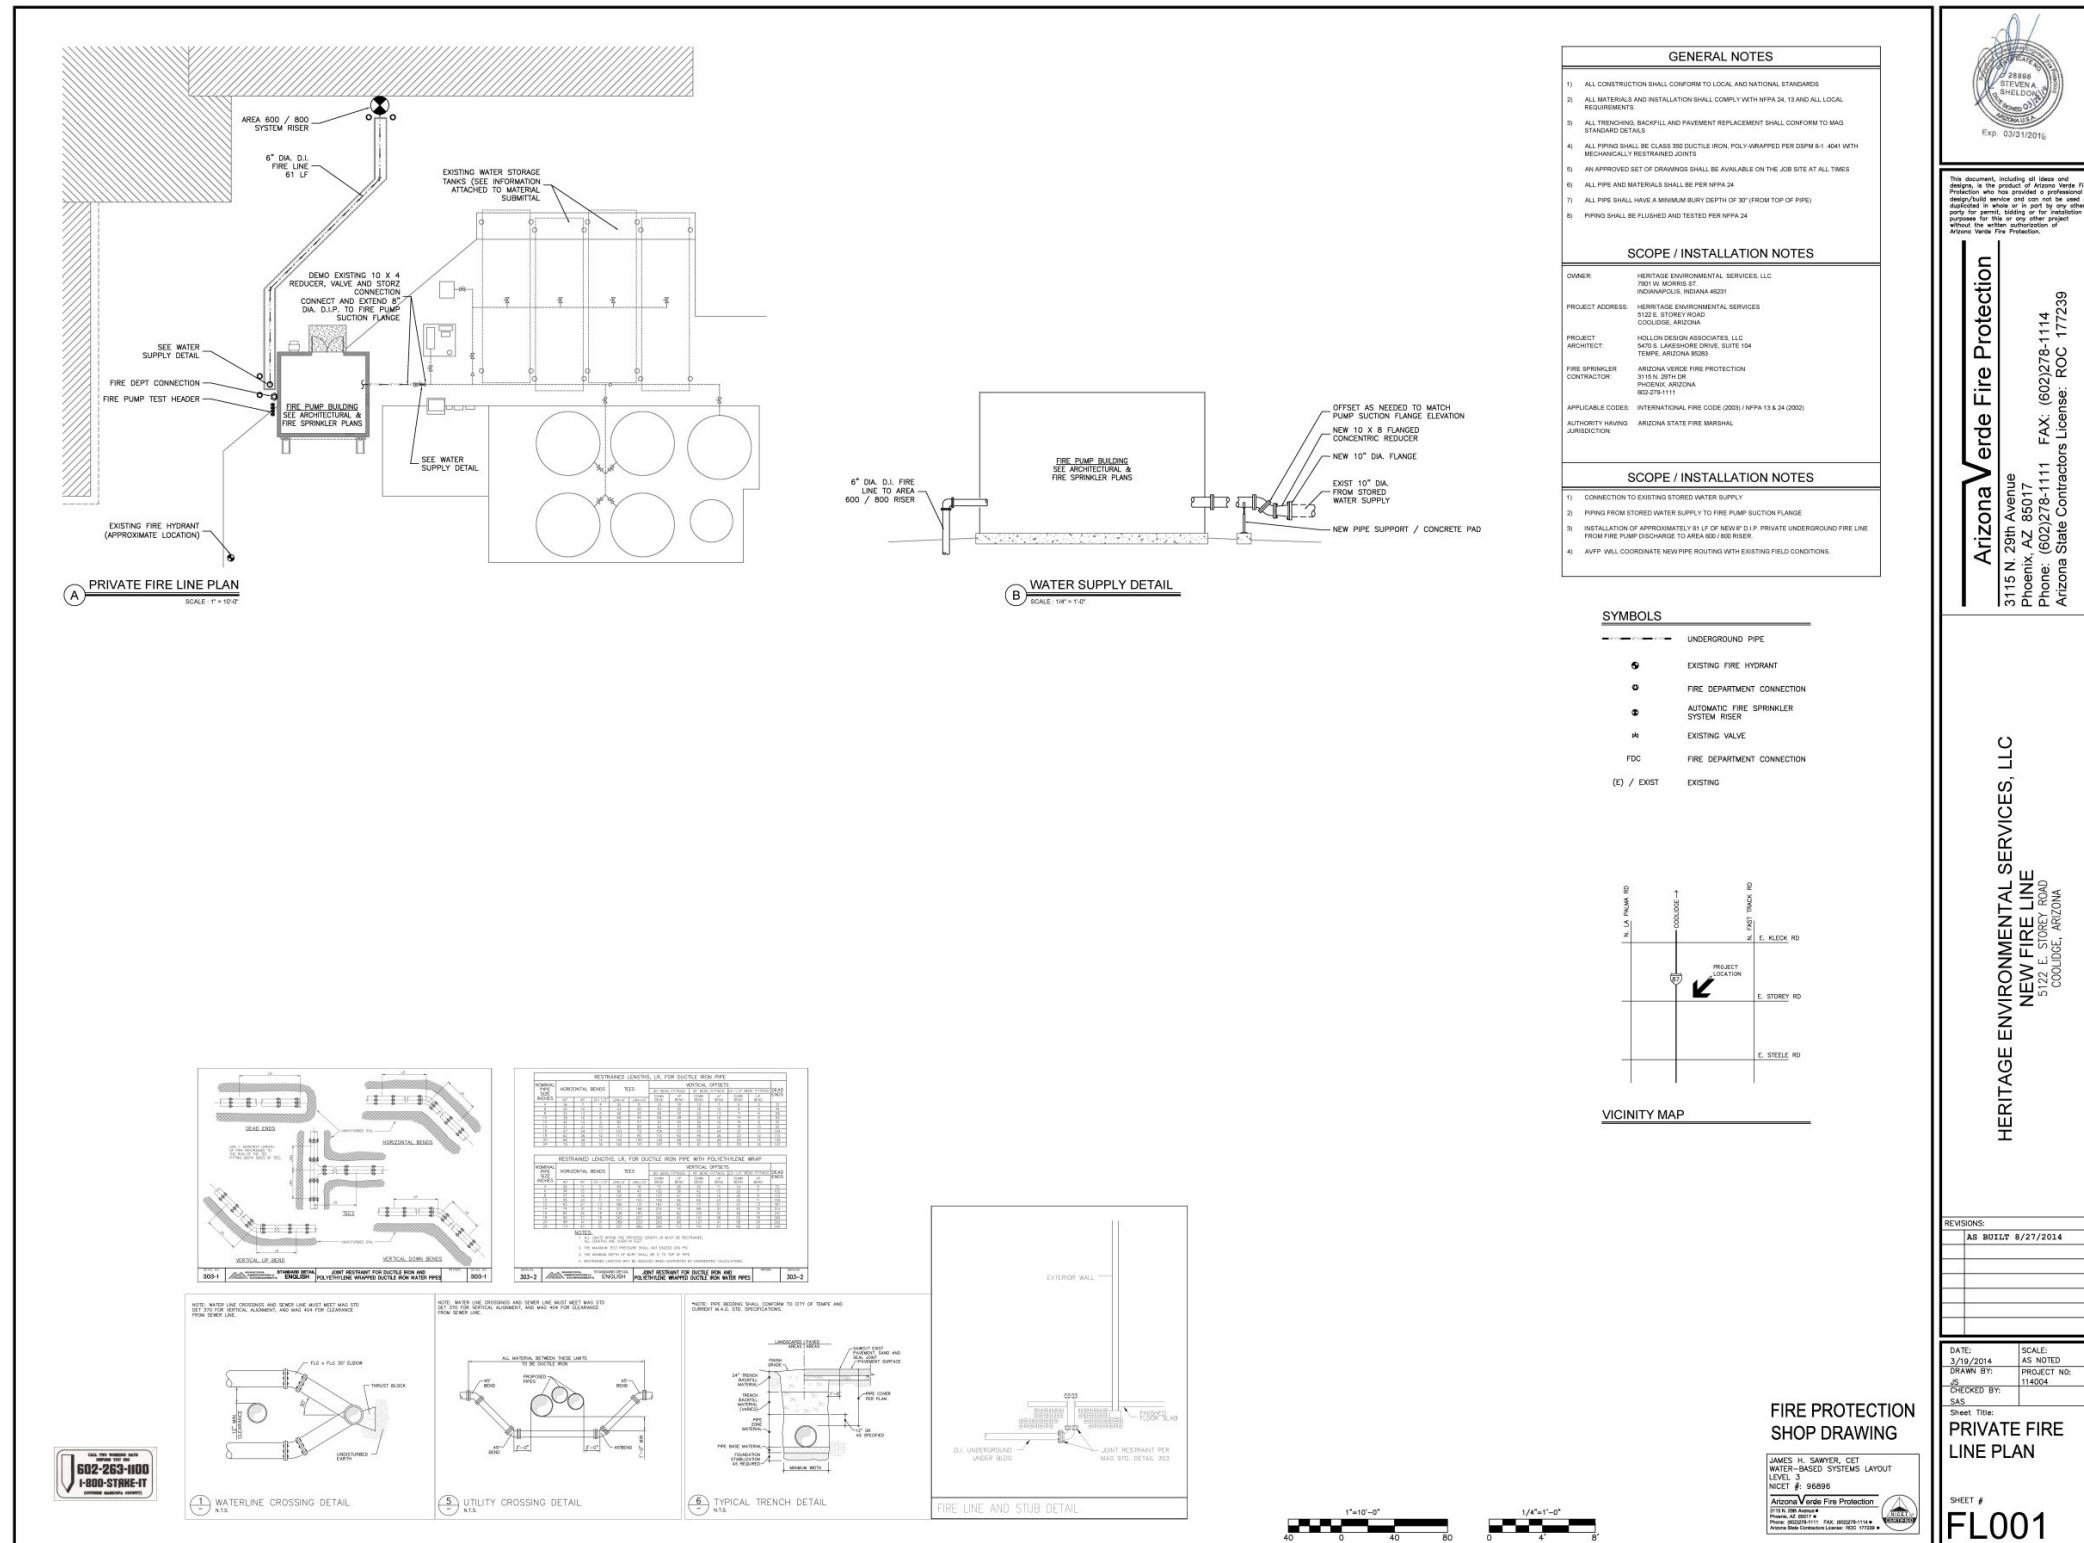






**AS BUILT PUMPHOUSE**



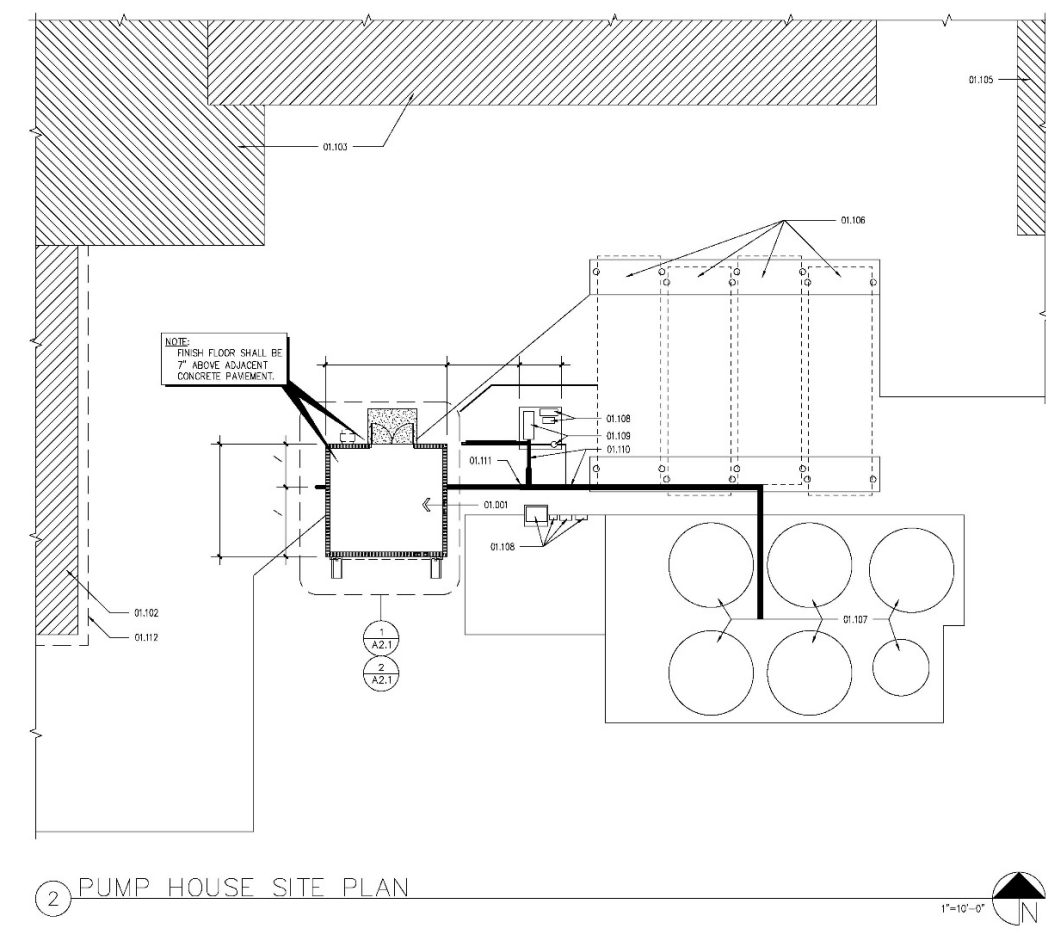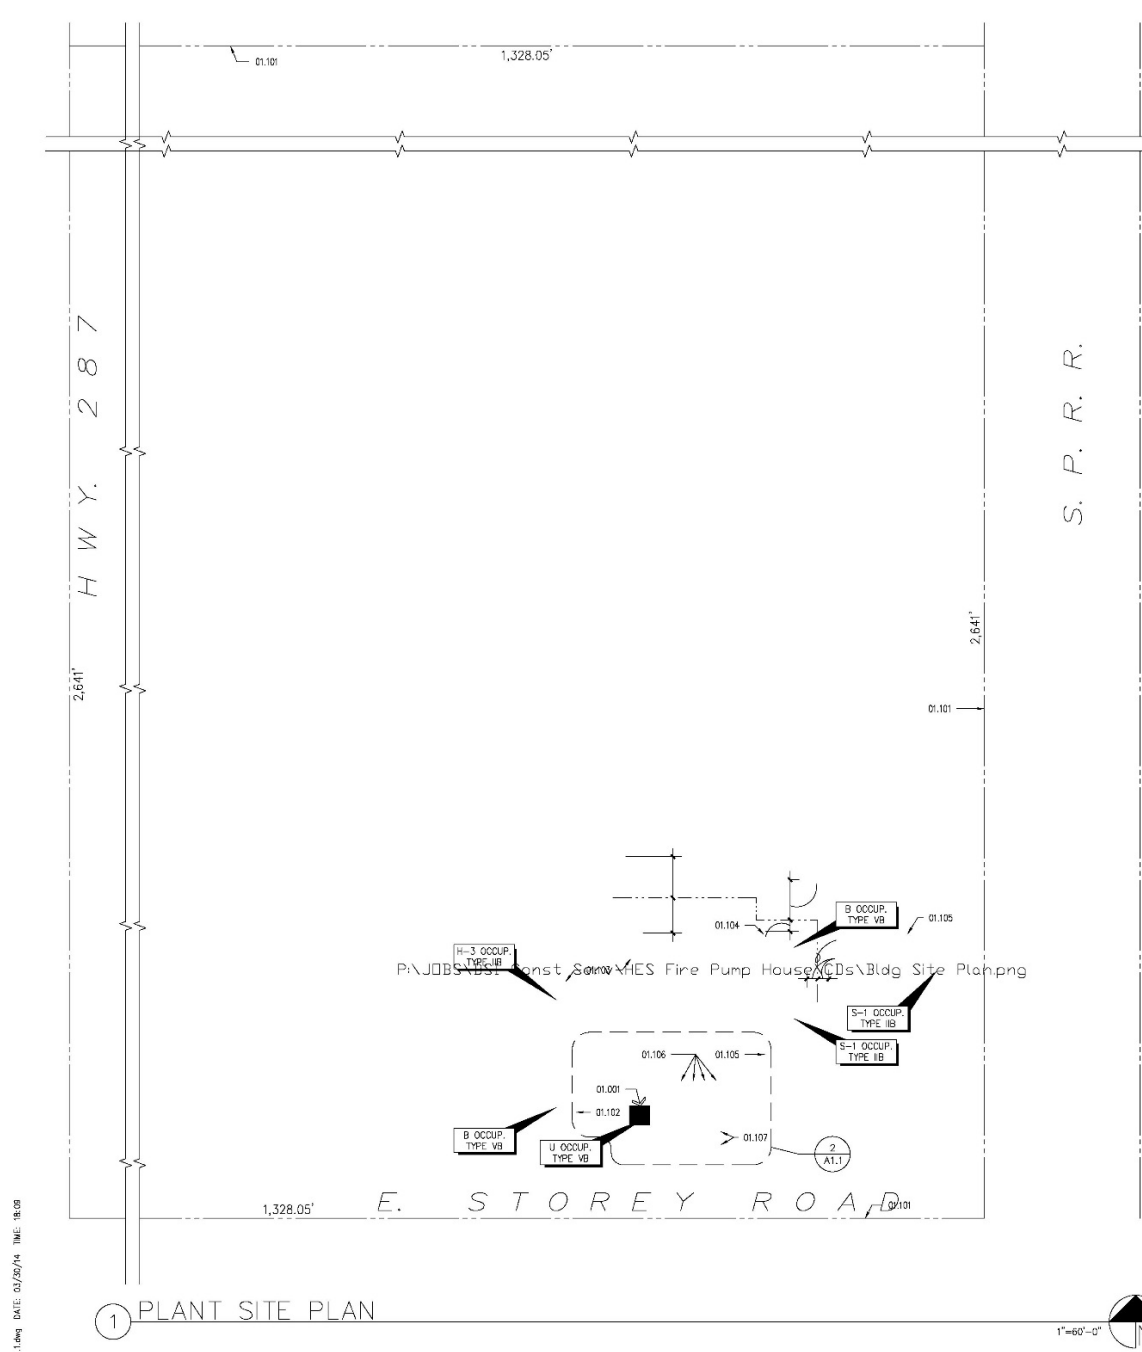

**AREA CALCULATION**

BUILDING AREA vs ALLOWABLE AREA for COMBINED BUILDING:		Allowable Areas:	Mixed Area Calculation:
Building Areas:	2,632 SF	For Group B, Type VB, non-sprinklered:	$\frac{2,632 + 17,390 + 1,168 + 3,852 + 278}{9,000 + 56,000 + 9,000 + 17,500 + 22,000} = 0.96 < 1.0$
Office Building:	17,390 SF	For Group S-1, Type IIB, non-sprinklered:	
Areas 600 & 800:	1,168 SF/per floor	For Group II-3, Type IIB, sprinklered:	
Laboratory Building:	3,852 SF	42,000 SF for fire sprinklers	
Area 500:	278 SF	56,000 SF	
Fire Pump House:	278 SF	For Group U, Type IIB, sprinklered:	5,500 SF (tabular)
Total Building Area:	25,300 SF	+16,500 SF for fire sprinklers	22,000 SF

**KEYNOTES**

**DIVISION 1 - GENERAL REQUIREMENTS**

**01.001 SCOPE OF WORK - FIRE PUMP HOUSE:**  
 Provide new masonry building for the installation of a new fire pump for a portion of the plant. Work to include excavation for concrete footing, concrete footing, load-bearing masonry walls, concrete floor slab, concrete equipment pad, hollow metal door, steel roof structure with metal roofing panels, mechanical, and electrical. The installation of the fire pump is to be done under a separate submittal and permit from the State Fire Marshal.

01.101 Property line.	01.107 Existing water tanks. Water is supplied from an on-site well. Water from this system will be used for the new fire sprinkler system.
01.102 Existing office building.	01.108 Existing electrical switchgear. See Electrical Drawings.
01.103 Existing storage buildings for flammable liquids. Installation of new automatic fire sprinkler system in Areas 600 and 800 to be done under a separate submittal and permit from the State Fire Marshal.	01.109 Existing electric motor driven water pump to remain.
01.104 Existing laboratory building to remain as is.	01.110 Existing water piping to remain.
01.105 Existing storage building with open sides to remain as is.	01.111 Connection point for new fire water piping per Fire Protection Drawings.
01.106 Existing elevated horizontal storage tanks for non-potable water to remain as is.	01.112 Dashed line indicates overhang of existing roof.


**OWNERSHIP OF DOCUMENTS**  
 This document is the intellectual property of Heritage Environmental Services, LLC. The client and design professional herein are the sole proprietors of Heritage Design Associates, LLC and are not to be reproduced, changed, or used by anyone in whole or in part, for any other project without written approval of Heritage Design Associates, LLC. © 2014 All rights reserved.


**HERITAGE ENVIRONMENTAL SERVICES, LLC**  
 5470 S. LAKESHORE DR. SUITE 104, TEMPE, ARIZONA 85283  
 480-897-7145 FAX 480-897-7105 architects@hds-az.com

PLANT SITE PLAN  
 PUMP HOUSE SITE PLAN


HERITAGE ENVIRONMENTAL SERVICES - FIRE PUMP HOUSE  
 2841 STOREY ROAD  
 COCHISE, ARIZONA 85726

JOB: 1402  
 DATE: 3/12  
 SHEET A1.1

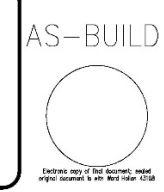


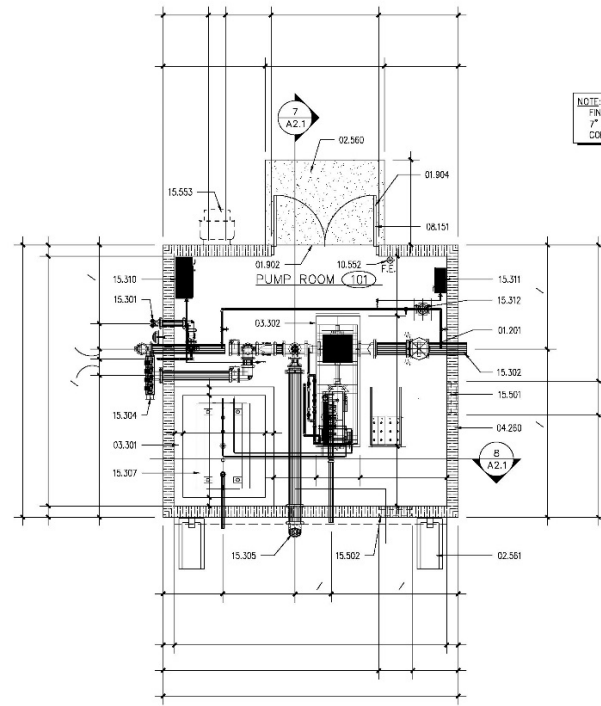


1 FLOOR PLAN 1/4"=1'-0"

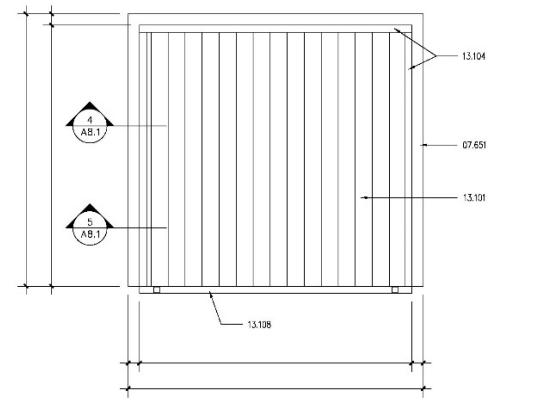


2 ROOF PLAN 1/4"=1'-0"

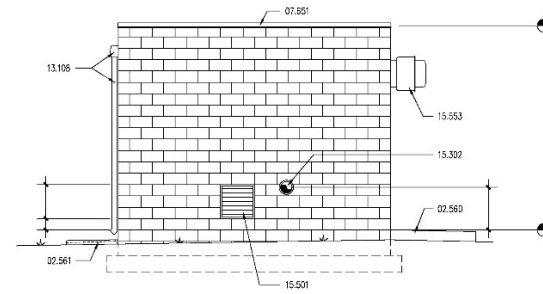


3 EAST ELEVATION 1/4"=1'-0"

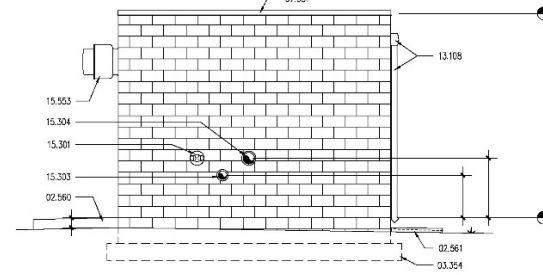


5 WEST ELEVATION 1/4"=1'-0"

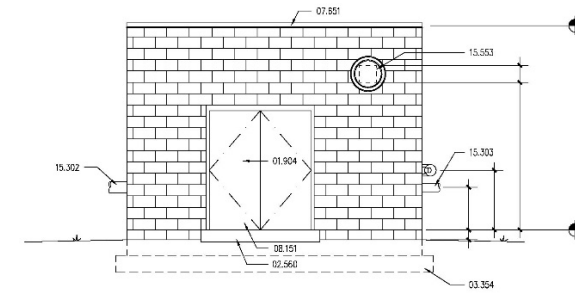


4 NORTH ELEVATION 1/4"=1'-0"

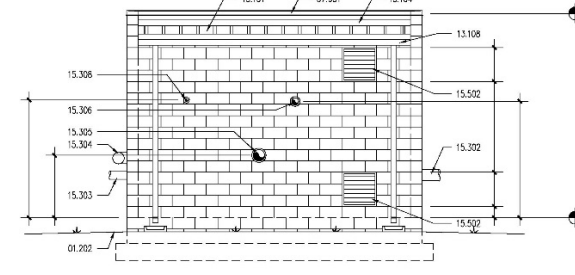

6 SOUTH ELEVATION 1/4"=1'-0"

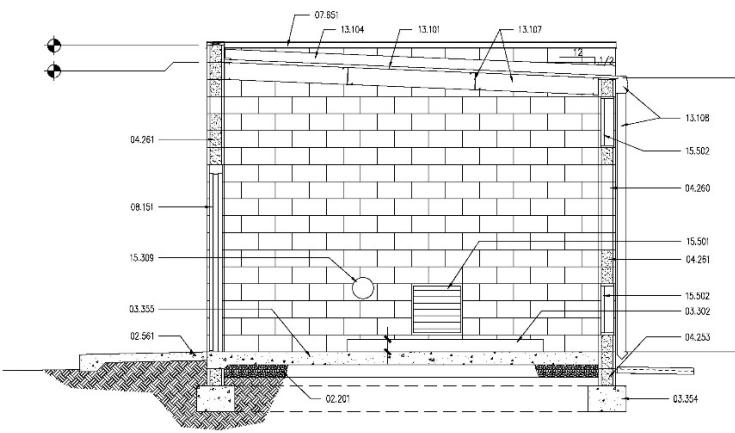


7 BUILDING SECTION 3/8"=1'-0"

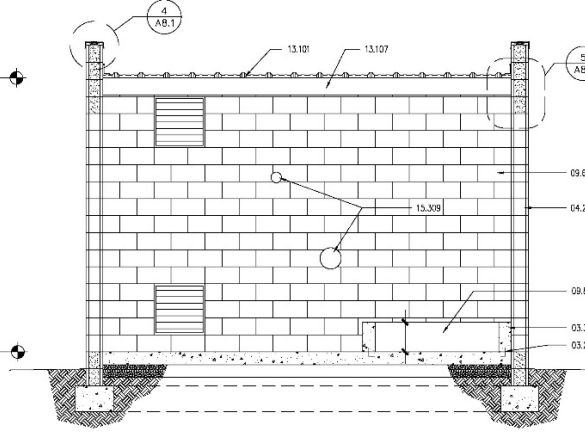

8 BUILDING SECTION 3/8"=1'-0"

KEYNOTES	
<b>DIVISION 1 - GENERAL REQUIREMENTS</b>	<b>DIVISION 3 - CONCRETE</b>
01.201 Fire protection piping, fire pump, diesel engine, fuel tank, etc. to be provided by Fire Protection contractor under a separate permit.	03.201 Rubber waterstop. See Specifications and Structural Drawings.
01.202 Line of existing grade.	03.301 Concrete containment curb. See Structural Drawings.
01.902 Landing shall be flush with finish floor, typical.	03.302 Concrete equipment pad. See Structural Drawings.
01.904 Inactive door leaf.	03.354 Concrete footing. See Structural Drawings.
<b>DIVISION 2 - SITE WORK/DEMOLITION</b>	03.355 Concrete floor slab. See Structural Drawings.
02.201 6" compacted base course. See Structural Drawings.	<b>DIVISION 4 - MASONRY</b>
02.560 4" concrete pad, thicken edges to 8" at exposed edges.	04.253 Grout solid below grade.
02.561 Precast concrete splashblock.	04.260 Reinforced CMU wall. See Structural Drawings.
	04.261 Reinforced bond beam. See Structural Drawings.
	<b>DIVISION 7 - THERMAL AND MOISTURE PROTECTION</b>
	07.851 Metal galvanized cap flashing. Prime and paint as scheduled.
	<b>DIVISION 8 - DOORS AND WINDOWS</b>
	08.151 Hollow metal door and frame.
	<b>DIVISION 9 - FINISHES</b>
	09.801 Paint all exposed surfaces of concrete containment curbs and floors with polycarbonate film sealer. See Specifications.
	<b>DIVISION 10 - SPECIALTIES</b>
	10.552 ADA compliant wall mounted 2-A-10-BC fire extinguisher.
	<b>DIVISION 13 - SPECIAL CONSTRUCTION</b>
	13.101 Metal building galvalume roofing panels.
	13.104 Parapet rake flashing.
	13.107 8" metal "Z"-Get and track ledger. See Structural Drawings.
	13.108 Continuous gutter and 4" x 4" down spout.
	<b>DIVISION 15 - PLUMBING</b>
	15.301 FDC by Fire Protection Contractor.
	15.302 Fire water line to fire pump by Fire Protection Contractor.
	15.303 Fire water line from fire pump to new fire sprinkler system by Fire Protection Contractor.
	15.304 Fire water line to fire pump test heater by Fire Protection Contractor.
	15.305 Fire water relief pipe by Fire Protection Contractor.
	15.306 Diesel exhaust pipe by Fire Protection Contractor.
	15.307 Diesel fuel tank by Fire Protection Contractor. Set in concrete containment basin.
	15.308 Diesel fuel fill pipe by Fire Protection Contractor.
	15.308 Fire Protection Contractor to bore all openings in masonry wall for fire pump system.
	15.310 Fire pump control panel to be installed by Fire Protection Contractor. See Electrical Drawings for power connection.
	15.311 Jockey pump control panel to be installed by Fire Protection Contractor. See Electrical Drawings for power connection.
	15.312 Electric jockey pump to be installed by Fire Protection Contractor. See Electrical Drawings for power connection.
	<b>DIVISION 15.5 - MECHANICAL</b>
	15.501 Ventilation tower. See Mechanical Drawings.
	15.502 Combustion air lower. See Mechanical Drawings.
	15.553 Exhaust fan. See Mechanical Drawings.

AS-BUILD

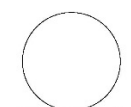

**OWNERSHIP OF DOCUMENTS**  
 This Document is an Instrument of Service. The Owner and design professional herein are the sole proprietors of this design. This document is not to be reproduced, altered, or used by anyone in whole or in part for any other project without the approval of Holman Associates, LLC. © 2014. All rights reserved.

**H O L M A N A S S O C I A T E S , L L C**  
 ARCHITECTS  
 5470 S. LAKE SHORE DR. SUITE 104 TEMPE, ARIZONA 85283  
 480-887-7145 FAX 480-887-7100 architects@h-a-z.com

FLOOR PLAN  
 ROOF PLAN  
 BUILDING ELEVATIONS  
 BUILDING SECTIONS

HERITAGE ENVIRONMENTAL SERVICES - FIRE PUMP HOUSE  
 2844 E. STONEY ROAD  
 CAGUPEACH, ARIZONA 85118



JOB: 1402  
 DATE: 3/12  
 SHEET A2.1



ROOM FINISH SCHEDULE														
ROOM NO.	ROOM NAME	FLOOR		BASE		W A L L S						CEILING		NOTES
		FINISH	MATERIAL	MATERIAL	FINISH	NORTH	EAST	SOUTH	WEST	MATERIAL	FINISH	HEIGHT		

ROOM FINISH SCHEDULE CODES													
FLOOR		BASE		WALLS		FINISH		MATERIAL		CEILING		FINISH	
GENERAL NOTES							NOTES						

DOOR SCHEDULE														
DOOR NO.	DOOR ELEV.	DOOR SIZE	FRAME	DETAILS				HARDWARE ITEMS						NOTES
				HEAD	JAMB	SILL	LATCH SET	CLOSER	DOOR STOP	GLAZING	GLASS	GLASS	GLASS	

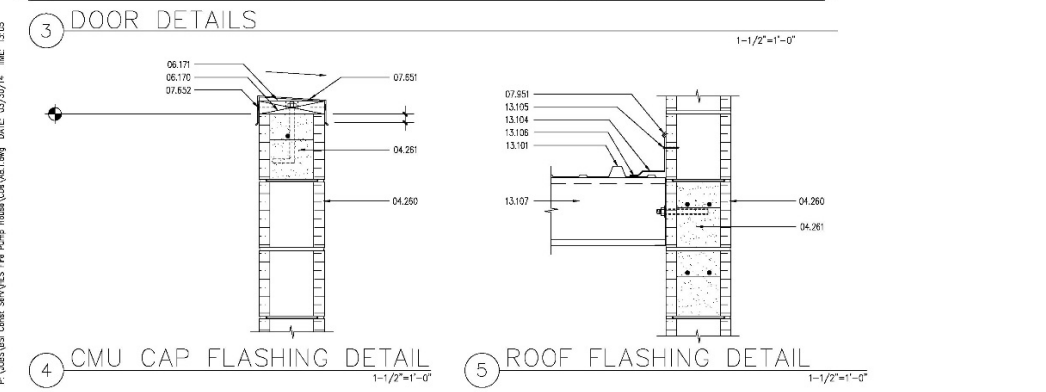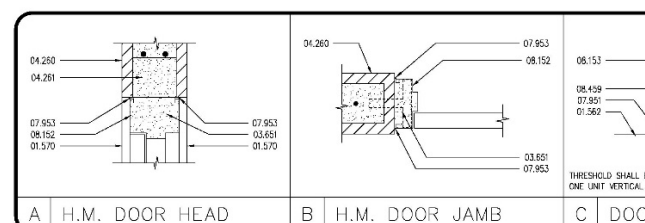

### KEYNOTES

**DIVISION 1 - GENERAL REQUIREMENTS**

01.562 Line of floor slab.

01.570 Line of CMU wall beyond.

**DIVISION 3 - CONCRETE**

03.651 Grout hollow metal frames solid.

**DIVISION 4 - MASONRY**

04.260 Reinforced CMU wall. See Structural Drawings.

04.281 Reinforced bond beam. See Structural Drawings.

**DIVISION 6 - WOOD AND PLASTICS**

06.170 Treat 2x4 continuous wood nailer, anchor @ 37" O.C. to bond beam with 1/2" x 4" end anchor bolts.

06.171 Continuous beveled cap siding tapered shim anchored to wood nailer.

07.651 Metal galvanized cap flashing. Prime and paint as scheduled.

07.652 Continuous steel cap, 24 gage min., fastened @ 8" o.c.

07.951 Sashline.

07.953 Sealant around all doors, windows, and other openings where two different materials meet. Typical for entire building.

08.152 Hollow metal frame. See Schedules and Elevations.

08.459 Aluminum threshold, ADA compliant.

**DIVISION 12 - SPECIAL CONSTRUCTION**

13.101 Metal building gable roof purlins.

13.104 Parapet rake flashing.

13.105 Fasteners @ 12" o.c.

13.106 Vents.

13.107 8" metal "L" Girt and track ledger. See Structural Drawings.

**TECHNICAL SPECIFICATIONS:**

**DIVISION 2 - SITE WORK/DEMOLITION**

**Section 02020 SELECTIVE DEMOLITION:**

- Scope of selective demolition work is indicated on Drawings.
- Owner assumes no responsibility for actual condition of items or structures to be demolished.
- Provide temporary shoring or other forms of protection as required to protect Owner's personnel and general public from injury due to selective demolition work.
- Promptly repair damages caused to adjacent facilities by demolition work at no cost to the Owner.
- Locate, identify, shut off and disconnect utility services that are not indicated to remain.
- If mechanical, electrical or structural elements which conflict with intended function or design are encountered, investigate and measure both nature and extent of the conflict. Submit report to Owner's representative in written, accurate detail. Hearing receipt of directive from Owner's Representative arrange selective demolition schedule as necessary to continue overall job progress on this job.
- Remove debris, rubbish and other materials resulting from demolition operations from building site. Transport and legally dispose of materials off site.
- Repair demolition performed in excess of that required. Rebuild structures and surfaces to meet condition existing prior to commencement of selective demolition work. Repair adjacent construction or surfaces affected or damaged by selective demolition work.

**Section 02000 EARTHWORK:**

- Locate existing underground utilities in areas of work. If utilities are to remain in place, support and protect during earthwork operations.
- Backfill open excavations and post warning lights as required.
- Excavation shall conform to elevations shown within 0.10'±.
- Scarify/compact top 12" of subgrade and each layer of backfill or fill material to at least 95% standard proctor density. Moisture content shall be an optimum ± 3% above the optimum moisture content.
- Uniformly grade areas to smooth finished surface within specified tolerances, compact with uniform levels or slopes between points where elevations are indicated, or between such points and existing grades.
- Lawn, gravel areas, walks:
  - A. Lawn, gravel areas, walks: 2.0"±
  - B. Basecourse: 4.0"±
  - C. Under building slab: 1.0"± with 30' stringcourse
- Place subbase course material in layers if uniform thickness.

**Section 02030 INTERIORS:**

- Provide chemoplastic elastomeric rubber waterstop as manufactured by Westec, St. Louis, MO, (900-759-2922), including:
  - A. Waterstop embedded in concrete and spanning contraction, control, expansion or construction joints to create a continuous diaphragm to prevent fluid migration.
  - B. Provide one following type where indicated on the Drawing:
    - 1. "Waterstop" Embedded 900 Series TREC, Style 801, 8" Ribbed center bulb waterstop for liquid-tight joints between non-concrete structures.
    - 2. Soliflex:
      - A. Provide factory fabricated waterstop intersections, leaving only straight butt joints for the field. Use Teflon covered chemoplastic controlled waterstop soliflex iron at 380' F to 440' F for TREC.
      - B. Field weld straight butt joint splices per requirements for shop fabricated fittings.
    - 3. Installation of ribbed seal web and ribbed centerbulb waterstop:
      - A. Use split formwork where required.
      - B. Center waterstop on joints. Cast each half directly into fresh concrete.
      - C. Allow clearance between waterstop and reinforcing steel to prevent rock pockets and air voids caused by aggregate interference.
      - D. At expansion joints, keep centerbulb positioned within the limits of the expansion joint material; do not extend centerbulb from being confined in concrete.
  - Secure waterstop in correct position using wires tied through waterstop evener to adjacent reinforcing bars.
  - Concrete placement at waterstop:
    - A. Carefully place concrete without displacing waterstop from proper position.
    - B. Thoroughly and systematically vibrate concrete around waterstop to obtain interlocks.
    - C. After first pour, clean unembedded waterstop top to ensure full contact of second pour concrete.

**Section 03000 CAST-IN-PLACE CONCRETE:**

- All concrete shall meet or exceed strengths in the General Structural Notes.
- Concrete work shall conform to the requirements of ACI 301.
- Provide proposed mix design.
- Formwork:
  - A. Formwork shall be used if needed for concrete below grade. New plywood or engineered forms shall be used if needed.
  - B. Form release Agent: All cleaned concrete forms shall be coated with a chemical release agent that is non-staining and that will not inhibit the natural bonding characteristics of secondary toppings or coatings, walls or sealers.
  - C. Approval products: Burke Form 01, 0.0.0. or approved equivalent.
- Reinforcing: See General Structural Notes and Structural Drawings.
- Sampling fresh concrete: ASTM C173, except modify for compliance with ASTM C94.
  - A. Slump: ASTM C143; measure and record the slump of each batch of concrete from which test specimens are taken.
  - B. Air Content: ASTM C231, volumetric method for lightweight or normal weight concrete; ASTM C231 pressure method for normal weight concrete; one for each day's pour of each type of air-entrained concrete. The concrete used in performing the air test shall not be used in fabricating test specimens.
  - C. Temperature: Determine and record the temperature in accordance with Test Method C1064.
  - D. Compression Test Specimen: ASTM C11; one set of 4 standard cylinders for each compressive strength test; and six cylinders directed 180° and three cylinders for laboratory cured test specimens except when field-cured test specimens are required.
  - E. Compression Strength Test: ASTM C109, one set for each day's pour exceeding 1 cu yd plus additional sets for each 30 cu yds. over and above the first 25 cu yds. of each concrete class placed in any direction; the specimen tested at 1 day, two specimens tested at 28 days, and one specimen retained in reserve for later testing if required.
  - F. Strength test results will be considered satisfactory if average of test of cores of consecutive strength test results equal or exceed specified compressive strength, and no individual strength test result falls below specified compressive strength by more than 500 psi.
  - G. Test results will be reported in writing to Architect, Structural Engineer, Contractor and Owner within 24 hours after tests. Reports of compressive strength tests shall contain the project identification name and number, date of concrete placement, use of concrete testing service, concrete type and class, location of concrete batch in structure, design compressive strength at 28 days, concrete mix proportions and materials; compressive breaking strength and type of break for each 2-day test; and 28-day tests.
  - H. Seal concrete floors where noted on finish schedule with VOC compliant water based acrylic clearcoater, "Tones & Seal" as manufactured by U.S. Construction Chemicals, Inc.
- Refer to Structural Drawings.

**DIVISION 4 - MASONRY**

**Section 04220 CONCRETE MASONRY:**

- The National Concrete Masonry Association (NCMA) "Guide Specifications for Concrete Masonry" is by reference made a part of this Specification.
- Submit Type "M" Certificates for compliance for masonry units.
- Insulation: Provide the following in all masonry walls:
  - A. Masonry foam insulation: Two component system consisting of urea-formaldehyde resin and a foaming agent surfactant.
  - B. Urethane foam insulation: Urethane foam spread, insulaid developed and fuel contributed of 0, 5 and 0 respectively.
  - C. Construction Characteristics: Must be non-combustible, Class A building material.
  - D. Thermal Values: Coefficient of 4.0 BTU/H·ft·°C degree F in. ASTM C177.
  - E. Sound Absorption: Minimum STC rating of 53 and a minimum STC rating of 41 for 8" wall assembly, ASTM E90.
- Engage an experienced dealer/applicator who are properly trained and certified in the use of urethane foam from production material and equipment.
- Fill all open cells and voids in hollow concrete masonry walls where shown on drawings. The foam insulation shall be pressure injected through a series of 5/8" to 7/8" holes drilled into every vertical column of block cells (every 8" on centers) beginning at an approximate height of four (4) feet from finished floor level. Spaces the procedure at an approximate height of ten (10) feet above the first horizontal row of holes (or as needed) until the void is completely filled. Each hole with mortar and score to resemble existing surface.
- Refer to STRUCTURAL DRAWINGS.

**Section 05000 METAL FABRICATIONS:**

- Contractor shall provide all miscellaneous steel such as supports, clips, angles, weld plates, ladders, ladders, anchor bolts, brackets and anything else of a miscellaneous nature necessary to complete the construction of this Project.
- Provide metal fabrications from materials of size, thickness, and shape indicated but not less than that needed to comply with performance requirements indicated.

**DIVISION 7 - THERMAL AND MOISTURE PROTECTION**

**Section 07000 FLASHING AND SHEET METAL:**

- All flashing shall be 24 gauge galvanized sheet steel, unless noted otherwise.
- Comply with manufacturer's installation instructions and recommendations, and with SMCW "Installation of Sheet Metal Flashing".
- Anchor units of work securely in place by methods indicated, providing for thermal expansion of metal joints; unless fasteners where possible, and set units true to line and level as indicated.
- Install work with laps, joints and seams which will be permanently watertight and weathertight.

**Section 07010 ELASTOMERIC JOINT SEALANTS:**

- Provide joint sealant, joint fillers and accessory joint materials that are compatible with one another and with joint substrates under project conditions.
- ELASTOMERIC SEALANTS:
  - A. Sealant Type A:
    - 1) For exterior joints in vertical surfaces and non-traffic horizontal surfaces provide single-component or multi-component, low-modulus, non-sag sealant; comply with ASTM C820, Type 5 or H, Grade 45, Class 25.
    - 2) Acceptable urethane sealants from Tremco include:
      - a. Vulcan 921, Domestic; Tremflex 35, Vulcan 145, Vulcan 931, or approved equal.
  - B. Sealant Type B:
    - 1) For interior joints in vertical surfaces and non-traffic horizontal surfaces.
    - 2) Acceptable single component sealants from Tremco include:
      - a. Domestic; Vulcan 135, Vulcan 921, Tremflex 25, Vulcan 912, Vulcan 932, or approved equal.
  - C. Sealant Type C:
    - 1) For exterior and interior joints in horizontal and sloped traffic surfaces, provide single-component or multi-component, polysulfide sealant having a Shore "A" hardness of not less than 25 or more than 30 and minimum 75 percent joint movement capability; comply with ASTM C820, Type 5 or H, Grade P or G, Class 25.
    - 2) Acceptable sealants from Tremco include:
      - a. TMC-005/901, Vulcan 945, Tremflex SL, Vulcan 45, Vulcan 227, or approved equal.
- Accessories:
  - A. Joint cleaner: Cleaner as recommended by sealant manufacturer for substrates indicated.
  - B. Joint primer: As recommended by sealant manufacturer for substrates, conditions and exposures indicated.
  - C. Bond breaker: Polyethylene tape or other adhesive faced tape as recommended by sealant manufacturer to prevent sealant contact where it would be detrimental to sealant performance.
  - D. Seals Backer: Polyethylene foam rod or other compatible non-curing non-expanding non-reinforcing resilient material in diameter 25 percent to 50 percent wider than joint width as recommended by sealant manufacturer for conditions and exposures indicated.
  - E. Masking tape: Non-staining, non-conductive tape product compatible with joint sealants and adjacent joint surface that is suitable for masking.
  - F. Provide other materials, not specifically described but required for a complete and proper installation, as selected by the Contractor and approved by the sealant manufacturer as compatible, subject to review of the Architect.

**DIVISION 8 - DOORS AND WINDOWS**

**Section 08110 STEEL DOORS AND FRAMES:**

- Standard steel door and frame specifications of the Steel Door Institute - SDI-100 is hereby by reference made a part of this Specification.
  - A. Whenever practicable, provide set-up and welded door frames as a pre-welded unit.
  - B. Submit shop drawings.
  - C. Approved suppliers: Steelcraft, Trussco Inc., Republic Builders Products, Curries or as approved.
  - D. Exterior doors - 16 gage, galvanized with closed tools
  - E. Interior doors - 18 gage, galvanized
  - F. Interior frames - 18 gage
  - G. Where fire door assembly are required, comply with ASTM E112 and NFPA 80 "Standard for Fire Doors and Windows".

**Section 08120 FINISH HARDWARE:**

- Finish hardware includes items used commercially as finish hardware which are required for swing, sliding and folding doors or gates.
- Types of finish hardware include, but are not limited to the following:
  - A. Hinges, stops
  - B. Lock of hinges & keys
  - C. Lock and latch sets
  - D. Exit devices
  - E. Push/pull plates
  - F. Closers
  - G. Hinges/rollers
  - H. Stops, buffers
  - I. Hardware accessories on all doors.
  - J. Hardware finish shall be US20, u.s.o.
- Locks and latches shall be ADE A136.2 Series 4000 Grade 1 Extra Heavy Duty Commercial.

**DIVISION 9 - FINISHES**

**Section 09000 SPECIAL FINISHES:**

- Polyurethane/Polyurethane Film Sealer:
  - A. Seal all exposed concrete surfaces of fuel containment basin.
  - B. Apply polyurethane/polyurethane film sealer, Ultra Shield II-C as manufactured by Pro-Seal Chemical, Inc. (800-348-7323) or approved equal, per manufacturer's instructions.
  - C. Color: Clear
  - D. Surface must be dry, clean and free of all loose particulate and bond-breaking matter.
  - E. Meet PPE when applying.

**Section 09000 PAINTS:**

- Work includes priming and finishing of interior and exterior exposed items and surfaces throughout Project, except as otherwise noted. This shall include but not limited to: M. Doors and frames, all gypsum board surfaces, metal flashing, counter flashing, stucco, concrete masonry, and related wall and ceiling.
- Related work includes, but is not limited to:
  - A. Shop applied prime coats and factory applied finishes.
  - B. Quality assurance.
  - C. Coordinate with other subcontractors and manufacturer to ensure compatibility.
  - D. Protect materials and exposed surfaces.
  - E. Uniform coats, runs, or holidays will not be permitted.
  - F. Test questionable concrete surfaces with acid detergent and muriatic acid.
  - G. Spray prime on metal surfaces that have been shop-primed and touch up painted.
- Acceptable manufacturers:
  - A. Sherwin-Williams, Pittsburgh Paints, Dunn-Edwards, Franes, Benjamin Moore & Co.
- Contractor shall furnish recommended priming coats and procedures and submit to Architect for approval for his preferred manufacturer for the following applications:
  - 1. Pittsburgh Paints Specification used as a guide.
  - 2. Specify Interior/Exterior Masonry Block Filler (0-7).
  - 3. Prime:
    - A. Pittsburgh Interior/Exterior Rust Inhibitive Primer (0-802)
    - B. Pittsburgh Primer (0-832)
    - C. Interior finish primer materials.
    - D. Sherwin-Williams Interior/Exterior Rust Inhibitive Primer (0-804 Series)
    - E. Pittsburgh Interior/Exterior Rust Inhibitive Primer (0-802)
    - F. Pittsburgh Interior/Exterior Rust Inhibitive Primer (0-802)
  - 4. Exterior finish primer materials:
    - A. Sherwin-Williams Interior/Exterior Rust Inhibitive Primer (0-804 Series)
    - B. Pittsburgh Interior/Exterior Rust Inhibitive Primer (0-802)
    - C. Pittsburgh Primer (0-832)
    - D. Sherwin-Williams Interior/Exterior Rust Inhibitive Primer (0-804 Series)
  - 5. Exterior Paint Systems (EPS):
    - A. EPS-1: Concrete Masonry Units (CMU)
      - 1) Primer: 1 coat - Sherwin-Williams Masonry Block Filler (0-7), 4.0 to 14.0 Mils DFT.
      - 2) Primer: 1 coat - Sherwin-Williams Interior/Exterior Rust Inhibitive Primer (0-802), 1.0 to 1.5 Mils DFT.
      - 3) Finish: 2 coats - Pittsburgh Paints Rust Inhibitive Primer (0-802), 1.5 to 2.0 Mils DFT.
      - 4) EPS-1: Sherwin-Williams
    - B. EPS-2: Concrete Masonry Units (CMU)
      - 1) Primer: 1 coat - Sherwin-Williams Masonry Block Filler (0-7), 4.0 to 14.0 Mils DFT.
      - 2) Primer: 1 coat - Sherwin-Williams Interior/Exterior Rust Inhibitive Primer (0-802), 1.0 to 1.5 Mils DFT.
      - 3) Finish: Coats as Identified in Room Finish Schedule for system above.
      - 4) EPS-2: Sherwin-Williams
    - C. EPS-3: Concrete Masonry Units (CMU)
      - 1) Primer: 1 coat - Pittsburgh Paints Rust Inhibitive Primer (0-802), 1.5 to 2.0 Mils DFT.
      - 2) Finish: 2 coats - Pittsburgh Paints Rust Inhibitive Primer (0-802), 1.5 to 2.0 Mils DFT.
      - 3) EPS-3: Sherwin-Williams

**DIVISION 10 - SPECIALTIES**

**Section 10120 FIRE EXTINGUISHERS, CABINETS AND ACCESSORIES:**

- Mount and install 10# ABC type fire extinguishers as located on the Drawings.
- Extinguishers to handle A, B & C type fires.

**DIVISION 12 - SPECIAL CONSTRUCTION**

**Section 12220 PREENGINEERED METAL BUILDINGS:**

- Provide pre-engineered building components as shown on Drawings.
- Roofing is to be manufacturer's standard roof panel. Color to be selected from manufacturer's standard colors.
- Deliver and store prefabricated components, sheets, panels, and other manufactured items as they will not be damaged or deformed.
  - A. Stack materials on platforms or pallets, covered with canvas or other suitable weather-resistant covering. Store metal sheets or panels so that water accumulation will drain freely. Do not store sheets or panels in contact with other materials which might cause staining.

**DIVISION 13 - MECHANICAL SYSTEMS**

**Section 15000 HEATING, VENTILATION AND AIR CONDITIONING:**

- See Mechanical Drawings.

**DIVISION 16 - ELECTRICAL**

**Section 16000 ELECTRICAL:**

- See Electrical Drawings.
- Contractor shall provide rough-in for Owner furnished equipment.

**OWNERSHIP OF DOCUMENTS**

This Document is the intellectual property of Heritage Environmental Services, LLC and is the property of the client. It is to be used only for the project for which it was prepared, or used in whole or in part for any other project without the written authorization of Heritage Environmental Services, LLC. © 2014. All rights reserved.

**HERITAGE ENVIRONMENTAL SERVICES, LLC**

5470 S. LAKESHORE DR. SUITE 100 TEMPE, ARIZONA 85283  
 480-897-7145 FAX 480-897-7145

**ROOM FINISH SCHEDULE**

**DOOR SCHEDULE & DETAILS**

**DETAILS**

**SPECIFICATIONS**

**MECHANICAL SYSTEMS**


**HEATING, VENTILATION AND AIR CONDITIONING**

**9841 - 1 STORY ROOF**

**COBLENCE, ARIZONA 85278**

JOB: 1402  
 DATE: 3/12

SHEET A8.1

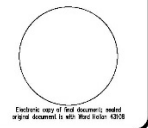



**NOTES:**

1. FINISHED GRADE WHERE OCCURS. DO NOT EXCAVATE A TRENCH CLOSER THAN PER SECTION BELOW BOTTOM OF FOOTING OR FOUNDATION.
2. BOTTOM OF CONCRETE FOOTING, BOTTOM OF TRENCH, WHERE TRENCH IS DEEPER THAN SHOWN, SEE DETAIL (105-18.76).
3. TYPICAL UNLESS NOTED OTHERWISE IN SOIL REPORT.

**09 TRENCH PARALLEL TO FOUNDATION** 105-20 NO SCALE  
12.3.2007

**NOTES:**

1. FINISHED GRADE WHERE OCCURS. SLURRY - PROVIDE 1/2" MINIMUM CLEARANCE AROUND PIPE OR CONDUIT.
2. HORIZONTAL PIPE OR CONDUIT.
3. STEM WALL.
4. CONCRETE FOOTING.
5. VERTICAL PIPE OR CONDUIT WHEN LOCATED AT STEM WALL - TRANSFER AT FLOOR LINE.
6. FINISHED FLOOR LINE.
7. 1 1/2" MIN CLEAR EXTERIOR FACE OF WALL AND NOTCH. NO REINFORCING MAY BE CUT. DAMAGE TO STEM WALL SHALL BE REPAIRED AND PATCHED TO MATCH ADJACENT WALL.

**10 PIPE AT FOUNDATION STEM WALL** 105-24 NO SCALE  
12.3.2007

**NOTE:**

1. NO PIPE SHALL PASS THRU FOOTING OR UNDER COLUMN FOOTINGS.
2. FOR ADDITIONAL INFORMATION, SEE PLANS AND DETAILS.

**NOTES:**

1. FINISHED GRADE WHERE OCCURS.
2. CORNER BARS SAME SIZE AND SPACING AS HORIZONTAL REINFORCING - LAP PER G.S.N. (24" MINIMUM).
3. CONCRETE STEM WALL OR FOOTING.
4. REINFORCING PER PLANS AND/OR DETAILS.
5. CORNER BARS AT MULTIPLE REINFORCING.

**05 PLAN - CORNER REINFORCING IN CONCRETE FOOTING, STEM OR WALL** 105-02 NO SCALE  
12.3.2007

**NOTES:**

1. CONCRETE FOOTING.
2. SLURRY - PROVIDE 1/2" MINIMUM CLEARANCE AROUND PIPE OR CONDUIT.
3. PIPE ON CONDUIT.
4. CONCRETE FILL TO BE PLACED BEFORE FOOTING IS POURED - FORM BARS AS FOOTING AND POUR FULL NORTH OF PIPE TRENCH.
5. STEM WALL.
6. 1"-8" MAXIMUM - WHERE TRENCH EXCEEDS 1"-8" NOTIFY STRUCTURAL ENGINEER PRIOR TO PLACEMENT OF FOOTING. BACKFILL AND RECOMPACT TRENCH PER SOIL REPORT AND SPECIFICATIONS.
7. BOTTOM OF TRENCH.

**06 PIPE PASSING UNDER WALL FOOTING** 105-30 NO SCALE  
12.3.2007

**NOTE:**

1. NO PIPE SHALL PASS THRU FOOTING OR UNDER COLUMN FOOTINGS.
2. FOR ADDITIONAL INFORMATION, SEE PLANS AND DETAILS.

**NOTES:**

1. MASONRY WALL.
2. BOND BEAM REINFORCING.
3. CORNER BARS SAME SIZE AND SPACING AS HORIZONTAL REINFORCING - LAP PER G.S.N. (24" MINIMUM).
4. SINGLE BAR REINFORCING WHERE OCCURS. ALTERNATE END OF CORNER BARS AT INTERSECTION.

**07 MASONRY BOND BEAM AT INTERSECTING WALLS** 510-01 NO SCALE  
9.11.2003

**NOTE:** SEE TYPICAL DETAIL FOR NON-TODDED ABUTTING WALLS AS OCCURS.

**NOTES:**

1. MASONRY WALL.
2. DEPTH OF MASONRY LINTEL - SEE PLANS AND DETAILS.
3. LATEL REINFORCING.
4. JAMB REINFORCING PER G.S.N. OR DETAILS SHOWN ON PLAN.
5. 2" OF SAND IN 4" DEEP SLEEVES BENEATH BOND BEAM - ROOT BARS UP AT WALL CORNERS WHERE MINIMUM CLEARANCE CANNOT BE ACHIEVED.
6. OPENING WIDTH OF GREATER.
7. OPENING WIDTH.
8. LATEL BLOCK AT OPENING.
9. OPEN ENDED BLOCK FULL DEPTH OF LATEL, EXTEND 24" EACH SIDE.
10. BOTTOM LINE OF BEARING.

**08 TYPICAL OPENING IN MASONRY WALL** 505-02 NO SCALE  
12.19.2001

**NOTE:** THIS SCHEDULE APPLIES ONLY IN THE EVENT THAT OVERSTRENGTHENED BARS NOT BEEN REINFORCED ON THE PLANS.

**NOTES:**

1. LAPS APPLY TO BOTH VERTICAL AND HORIZONTAL REINFORCING.
2. PROVIDE BENT BARS TO MATCH HORIZONTAL BOND BEAM REINFORCING AT CORNERS AND WALL INTERSECTION TO MAINTAIN BOND BEAM CONTINUITY.
3. DO NOT SPlice HORIZONTAL BARS WITHIN 6"-2' OF CONTROL JOINTS.
4. FOR LARGER TYPE HORIZONTAL REINFORCING, SEE G.S.N.
5. LAP LENGTHS ARE BASED ON A CALCULATED STEEL STRESS (N) NOT EXCEEDING 80 PERCENT OF THE ALLOWABLE STEEL STRESS (F<sub>a</sub>).

**WORKING STRESS MASONRY LAP SPICES FOR REINFORCING STEEL - 2008/2009 BIC** 501-102 NO SCALE  
6.4.2009

BOLT DIAMETER (IN)	VERT BOLT EMBEDMENT LENGTH	HORIZ BOLT EMBEDMENT LENGTH	ANCHOR FLUET WELD SIZE, "S"
1/2"	6"	4"	1/4"
5/8"	6"	4"	5/16"
3/4"	7"	5"	5/16"
7/8"	8"	6"	5/16"
1"	9"	7"	3/8"
1 1/8"	10"	8"	---
1 1/4"	11"	9"	---

**NOTES:**

1. PROVIDE ANCHORS, ANCHOR RODS AND ANCHOR BOLTS PER THIS SCHEDULE UNLESS NOTED OTHERWISE ON PLANS, SCHEDULES OR DETAILS.
2. AUTOMATIC WELDED TO DEVELOP FULL CAPACITY OF HIGH STRENGTH HEADED STUDS.
3. THICKNESS OF OFFSET DOES NOT APPLY TOWARD SCHEDULE.
4. BOLT/PLATE EDGE CLEARANCES FOR THE FOLLOWING - TOP BARS: 3/4" DIA OR LESS - 1 1/4" 7/8" DIA - 1 1/2" 1" DIA - 1 3/4" 1 1/4" DIA - 2 1/4" OVER 1 1/4" DIA - 1.75X DIA

**01 TYPICAL ANCHOR ROD, ANCHOR BOLT, ANCHOR AND HEADED STUD** 201-01 NO SCALE  
7.24.2003

CONC PSI	CLASS B TRENCH SPICE LENGTHS				COMP. BARS	
	REGULAR TOP	REGULAR TOP	REGULAR TOP	REGULAR TOP	STD LAP	W/ SPALL RES
#3 (10)	24"	31"	16"	24"	17"	22"
#4 (13)	32"	41"	25"	32"	22"	29"
#5 (16)	38"	51"	31"	40"	28"	36"
#6 (19)	47"	61"	37"	46"	33"	43"
#7 (22)	60"	80"	54"	70"	40"	50"
#8 (25)	78"	102"	62"	80"	50"	62"
#9 (29)	88"	115"	70"	91"	63"	81"
#10 (32)	96"	129"	78"	102"	70"	91"
#11 (36)	110"	143"	87"	113"	78"	101"

**NOTES:**

1. TOP BARS ARE ANY HORIZONTAL BARS PLACED SO THAT MORE THAN 12" OF FRESH CONCRETE IS CAST IN THE MEMBER BELOW THE REINFORCEMENT.
2. LAP SPICES SHALL BE CLASS "B" TRENCH LAP SPICES PER LATEST EDITION OF AC 308 UNLESS SPECIFICALLY NOTED OTHERWISE ON THE DRAWINGS OR SCHEDULES.
3. CONTACT STRUCTURAL ENGINEER IF CLEAR SPACING OF REINFORCEMENT IS LESS THAN 6" EQUAL TO 3 BAR DIAMETERS (3x), OR IF CLEAR COVER IS LESS THAN 3 BAR DIAMETER (3x).
4. THIS TABLE IS BASED ON NORMAL WEIGHT CONCRETE.
5. FOR ADDITIONAL INFORMATION, SEE G.S.N., PLANS, SCHEDULES AND DETAILS.

**LAP SCHEDULE FOR REINFORCING STEEL IN CONCRETE** 201-31.01 NO SCALE  
7.24.2003

**NOTES:**

1. LAP - SEE G.S.N.
2. MAXIMUM 1/3 LAP BUT NOT MORE THAN 4'
3. WRE PER
4. 12" MINIMUM
5. BARS-3M FOR BARS NOT OVER #6. 44 FOR #6, #8, AND #10. BARS 54 FOR #14 AND #16. BARS 54 FOR ALL GRADES 40 BARS WITH 180 DEGREE HOOK. 44" MINIMUM.
6. 124 (90 DEGREE HOOK).
7. 130 DEGREE BEND.
8. BEND AROUND 1 1/2" DIA FOR #3 BARS. BEND AROUND 2" DIA FOR #4 BARS. BEND AROUND 2 1/2" DIA FOR #5 BARS.
9. ROTATE "E" LOCATION 90 DEGREES EACH COURSE.

**03 TYPICAL CONCRETE REINFORCING BAR DETAILS** 401-07 NO SCALE  
7.24.2003

REBAR SIZE (METRIC)	REBAR GRADE	MASONRY LAP SPICE LENGTH			
		STEEL AT CENTER OF WALL	STEEL AT FACE OF WALL (& BOND BEAMS)	STEEL AT CENTER OF WALL	STEEL AT FACE OF WALL
#4 (13)	40	20"	20"	20"	20"
#4 (13)	60	20"	20"	20"	20"
#5 (16)	60	25"	25"	25"	25"
#6 (19)	60	N/A	30"	30"	30"
#7 (22)	60	N/A	35"	35"	35"
#8 (25)	60	N/A	N/A	40"	N/A

**NOTES:**

1. LAPS APPLY TO BOTH VERTICAL AND HORIZONTAL REINFORCING.
2. PROVIDE BENT BARS TO MATCH HORIZONTAL BOND BEAM REINFORCING AT CORNERS AND WALL INTERSECTION TO MAINTAIN BOND BEAM CONTINUITY.
3. DO NOT SPlice HORIZONTAL BARS WITHIN 6"-2' OF CONTROL JOINTS.
4. FOR LARGER TYPE HORIZONTAL REINFORCING, SEE G.S.N.
5. LAP LENGTHS ARE BASED ON A CALCULATED STEEL STRESS (N) NOT EXCEEDING 80 PERCENT OF THE ALLOWABLE STEEL STRESS (F<sub>a</sub>).

**CONTINUOUS FOOTING (WF) SCHEDULE** 901-03

MARK	HEIGHT	WIDTH	FOOTING REINFORCING	REMARKS
WF1	12"	1'-6"	2 #4	---

**MASONRY WALL REINFORCING (W) SCHEDULE** 913-01

MARK	VERTICAL REINFORCING	REMARKS
W1	#5 AT 48" O.C.	---

**PLAN NOTES - TYP. U.N.D.:**

1. VERIFY ALL DIMENSIONS WITH ARCHITECTURAL DRAWINGS AND FIELD CONDITIONS. BUILDING DIMENSIONS, WHERE SHOWN, WERE PROVIDED BY THE ARCHITECT AND SHALL BE VERIFIED WITH SAME PRIOR TO PROCEEDING WITH THE WORK. DO NOT USE CONC. C.I. FOR LOCATING BUILDING ELEMENTS.
2. TOP REINFORCING WHERE NOTED. LONGITUDINAL REINFORCING. EQUAL SPACING U.N.C.
3. TRANSVERSE REINFORCING.
4. WF1, WF2, ETC. - AS SHOWN ON PLAN INDICATES CONTINUOUS WALL FOOTING. SEE SCHEDULE THIS SHEET.
5. W1, W2, ETC. - AS SHOWN ON PLAN INDICATES MASONRY WALL REINFORCING. SEE SCHEDULE THIS SHEET. FOR ADDITIONAL INFORMATION, SEE G.S.N.
6. BUILDING CONCRETE SLAB ON GRADE SHALL BE AS NOTED ON PLAN. VERIFY EXACT SIZE AND LOCATION OF ADMIXTURE AND/OR BARS. SLABS WITH ARCH'L DRAWINGS FOR SCHEDULES LOCAL, SEE ARCH'L DRAWINGS. FOR ADDITIONAL INFORMATION, SEE G.S.N. AND TYPICAL DETAILS.
7. FOR CLARITY, DETAILS MAY SHOW ONLY ONE SIDE OF FRAMING CONDITIONS. ALL SPACINGS MAY NOT BE SHOWN ON THIS PLAN. FOR EXACT SIZE, NUMBER AND LOCATION OF DETAILS, SEE ARCHITECTURAL, MECHANICAL, PLUMBING, ELECTRICAL, SPRINKLER AND THEIR RELATED DRAWINGS. FOR FRAMING AT OPENINGS, SEE TYPICAL DETAILS.
8. VERIFY EXACT LOCATION OF EQUIPMENT AND SUPPORTS INDICATED ON PLAN WITH ARCHITECTURAL, MECHANICAL, PLUMBING, ELECTRICAL, SPRINKLER AND THEIR RELATED DRAWINGS.

**FOR ADDITIONAL INFORMATION SHOWN BUT NOT NOTED, SEE GENERAL STRUCTURAL NOTES ON SHEET S1.1 AND TYPICAL DETAIL SHEETS.**

**THESE DRAWINGS/CALCULATIONS ARE CONSIDERED PRELIMINARY - NOT FOR CONSTRUCTION OR RECORDING UNLESS THE STRUCTURAL ENGINEER OF RECORD'S SEAL IS AFFIXED WITH WRITTEN SIGNATURE.**

PROJECT NUMBER 14-232 PROJECT MANAGER CJA  
 PROJECT ENGINEER MJS PROJECT DRAFTER TMH

**CARUSO-TURLEY-SCOTT-INC**  
 consulting structural engineers  
 1215 West Rito Salado Parkway, Suite 200  
 Tempe, Arizona 85281 (480) 774-1700 (774-1701 FAX)  
 www.ctsi.com

**OWNERSHIP OF DOCUMENTS**  
 This document is the intellectual property of Heritage Environmental Services, LLC and shall remain the property of Heritage Environmental Services, LLC and shall not be reproduced, stored in a retrieval system, or used for any other project without written permission of Heritage Environmental Services, LLC. © 2013 All rights reserved.









**HOLN DESIGN ASSOCIATES, LLC**  
 5470 S. LAKESHORE DR. SUITE 104  
 TEMPE, ARIZONA 85283  
 480-887-7145  
 480-887-7145

**STRUCTURAL PLANS AND TYPICAL DETAILS**

**HERITAGE ENVIRONMENTAL SERVICES - FIRE PUMP HOUSE**  
 284 E. STOREY ROAD  
 COOEDICE, ARIZONA 85128

**JOB: 1402**  
**DATE: 3/12**  
**SHEET S1.2**

AS-BUILD

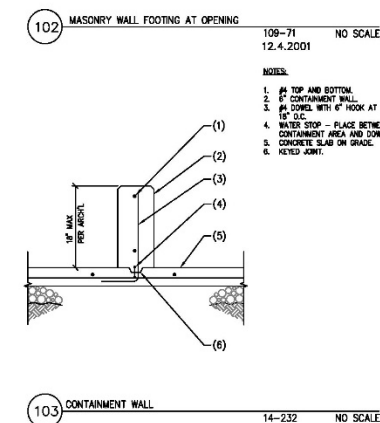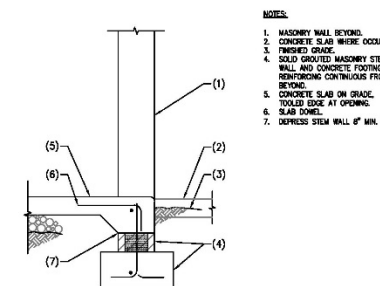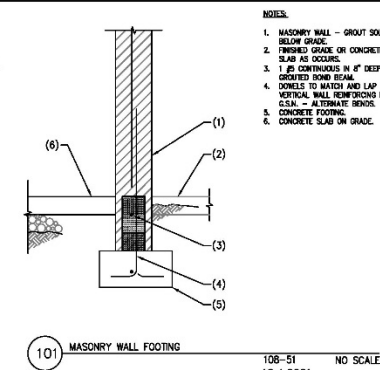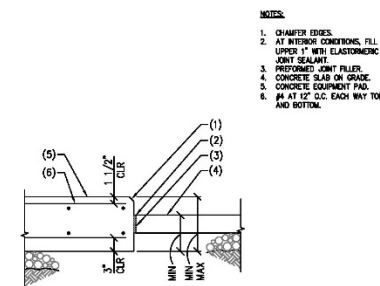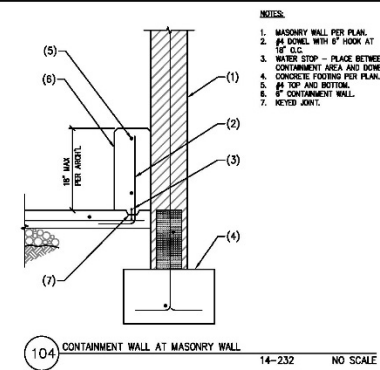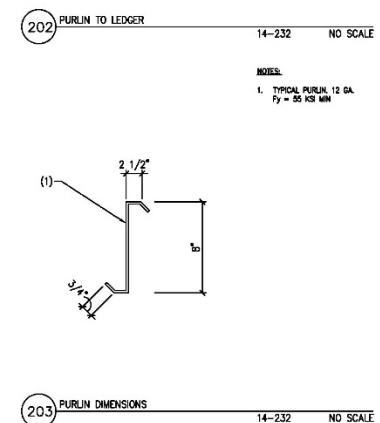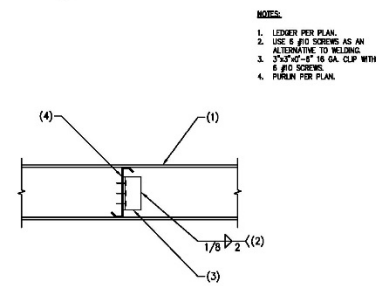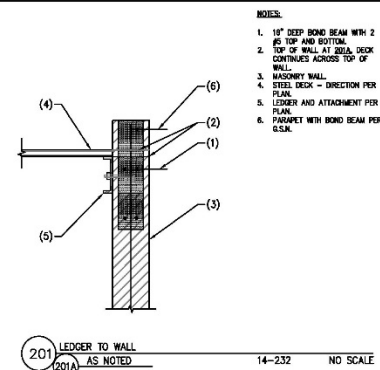

AS-BUILD

FOR ADDITIONAL INFORMATION SHOWN BUT NOT NOTED, SEE GENERAL STRUCTURAL NOTES ON SHEET S1.1 AND TYPICAL DETAIL SHEETS.  
 THESE DRAWINGS/CALCULATIONS ARE CONSIDERED PRELIMINARY - NOT FOR CONSTRUCTION OR RECORDING UNLESS THE STRUCTURAL ENGINEER OF RECORD'S SEAL IS AFFIXED WITH WRITTEN SIGNATURE.  
 PROJECT NUMBER 14-232 PROJECT MANAGER CJA  
 PROJECT ENGINEER MJS PROJECT DRAFTER TMH  
**CARUSO-TURLEY-SCOTT-INC**  
 consulting structural engineers  
 1215 West Rio Salado Parkway, Suite 200  
 Tempe, Arizona 85281 (480) 774-1700 (774-1701 FAX)

**OWNERSHIP OF DOCUMENTS**  
 This Document is the Intellectual Property of Heritage Environmental Services, LLC and its design professionals herein and the sole property of Heritage Environmental Services, LLC and its design professionals herein. It is not to be reproduced, changed or used for any other project without the written approval of Heritage Environmental Services, LLC.  
 © 2013 All rights reserved.

**H O L D I N G S**  
**A S S O C I A T E S , L L C**  
 5470 S. LAKE SHORE DR. SUITE 104 TEMPE, ARIZONA 85283  
 480-897-7145 480-897-7145 FAX

**STRUCTURAL DETAILS**

**HERITAGE ENVIRONMENTAL SERVICES - FIRE PUMP HOUSE**  
 284 E. STOREY ROAD  
 COOLIDGE, ARIZONA 85128

JOB: 1402  
 DATE: 3/12  
**SHEET S1.3**

**OWNERSHIP OF DOCUMENTS**  
 This document is the property of Heritage Environmental Services, LLC. The design and drawings incorporated herein are the sole property of Heritage Environmental Services, LLC and are not to be reproduced, stored in a retrieval system, or used in any way without the written permission of Heritage Environmental Services, LLC. © 2014 All rights reserved.

**HERITAGE ENVIRONMENTAL SERVICES, LLC**  
 5470 S. LAKE SHORE DR., SUITE 104 TEMPE, ARIZONA 85283  
 480-897-7145 FAX 480-897-7100 architects@hse-az.com

LOUVER SCHEDULE									
MARK	LOCATION	SERVICE	TYPE	MAT'L	MANUFACTURER	MODEL NO.	W X H X D	FINISH	REMARKS
L-1	FIRE PUMP ROOM	VENTILATION	MOTORIZED ADJUSTABLE DRAINABLE	STEEL	RUSKIN	LC6375D	24" X 24" X 6"	GALVANIZED	① ② ③ ④
L-2, L-3	FIRE PUMP ROOM	COMBUSTION AIR	MOTORIZED ADJUSTABLE DRAINABLE	STEEL	RUSKIN	LC6375D	24" X 24" X 6"	GALVANIZED	① ② ③ ④

- ① STORM PROOF DRAINABLE
- ② INSECT SCREEN, MATCH MAT'L
- ③ PROVIDE SHEET METAL SLEEVE FOR LOUVER, BLADES AND MOTOR MOUNTING
- ④ PROVIDE MOTORIZED DAMPER


FAN SCHEDULE											
MARK	TYPE	DRIVE	CFM	S.P. ("WC)	MAX RPM	MAX SONES	ELECTRICAL	DAMPER SIZE (IN.)	ROOF/WALL OPENING (IN.)	WEIGHT (LB)	MODEL AND REMARKS
EF-1	CENT EXHAUST	BELTED	875	.25	1549	12.4	1/4 HP 115v/1Ø	12x12	12.5x125.5	100	GREENHECK CFW-D8A-4 PUMP HOUSE EXHAUST

- 1. PROVIDE T-STAT AND CONTROLS FOR SUMMER VENTILATION WITH LOUVER MOTORIZED DAMPER AND EXHAUST FAN INTERLOCK.

Model: 100A001 00A0000  
 Serial: 100P100227-00/0000001  
 Greenheck Company, Phone: 417-969-8474 or www.greenheck.com

ELECTRIC HEATING UNIT SCHEDULE					
MARK	TYPE	HEAT INPUT (KW)	CFM	ELECTRICAL	MODEL AND REMARKS
UH-1	HORIZ PROP	7.5	590	1/20 HP 480V/3Ø	REZNOR EEE-7 Model: HE1738 2500, Max 1 Module Serial: 300000074-2300 Power: 480V not available. Setback to #10 wire, 250V/Single Phase/3Ø amp

- 1. MOUNTING HEIGHT 8'-0" AFF
- 2. PROVIDE MOUNTING HARDWARE.
- 3. SINGLE STAGE UNIT MOUNTED T-STAT. SET POINT AT 45' (ADJUSTABLE)
- 4. PROVIDE INTEGRAL POWER DISCONNECT W/OVERLOAD PROTECTION FOR BOTH FAN AND ELECTRIC HEATING COIL.

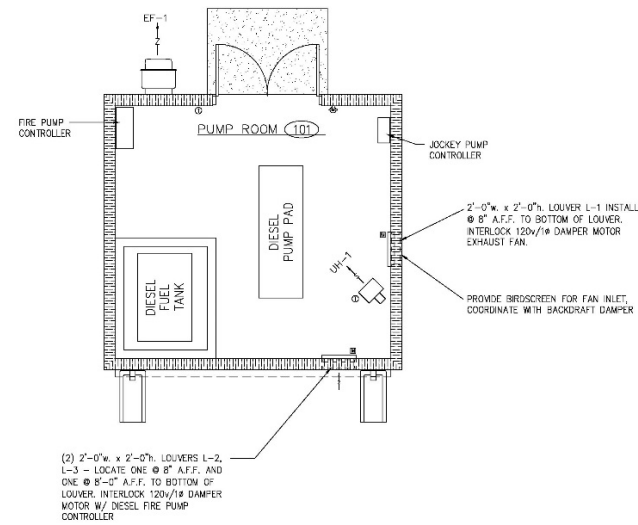

① HVAC PUMP HOUSE FLOOR PLAN 1/4"=1'-0"

HERITAGE ENVIRONMENTAL SERVICES, LLC  
 284 T. STREET ROAD  
 COOILIDGE, ARIZONA 85128

HERITAGE ENVIRONMENTAL SERVICES, LLC  
 284 T. STREET ROAD  
 COOILIDGE, ARIZONA 85128


AS-BUILD

JOB: 1402  
 DATE: 3/12  
 SHEET M2.1



**GENERAL NOTES – POWER**

- REFER TO ELECTRICAL SPECIFICATIONS FOR ADDITIONAL REQUIREMENTS AND COMPLETE CONTRACTUAL OBLIGATIONS.
- THE ELECTRICAL CONTRACTOR SHALL (PRIOR TO HIS BID) VISIT THE SITE AND FIELD VERIFY ALL EXISTING CONDITIONS AND TAKE ALL CONSIDERATIONS INTO ACCOUNT AT THE TIME OF BIDDING. NO ADDITIONAL CONSIDERATIONS WILL BE GRANTED THE CONTRACTOR AFTER THE BID IS ACCEPTED.
- ALL ELECTRICAL METALLIC TUBING (EMT), RIGID NON-METALLIC CONDUIT, FLEXIBLE METALLIC CONDUIT, FLEXIBLE NON-METALLIC CONDUITS, "SEALTIGHT" TYPE CONDUITS AND ALL OTHER CONDUITS THAT DO NOT CONTAIN A CODE SIZED GROUND WIRE SHALL HAVE A CODE SIZED BOND WIRE INSTALLED WITH THE CIRCUIT CONDUCTORS.
- RECEPTACLES LOCATED WITHIN 6'-0" OF SINKS OR WATER SHALL BE CONNECTED EITHER TO A GROUND FAULT CIRCUIT INTERRUPTER TYPE CIRCUIT BREAKER OR TO A GROUND FAULT CIRCUIT INTERRUPTER TYPE RECEPT.
- PRIOR TO ROUGH-IN, THE ELECTRICAL CONTRACTOR SHALL COORDINATE THE EXACT LOCATION OF ALL WIRING DEVICES TO INCLUDE MOUNTING HEIGHTS AND LOCATIONS. ALL CONFLICTS SHALL BE REPORTED TO THE ENGINEER/ARCHITECT.

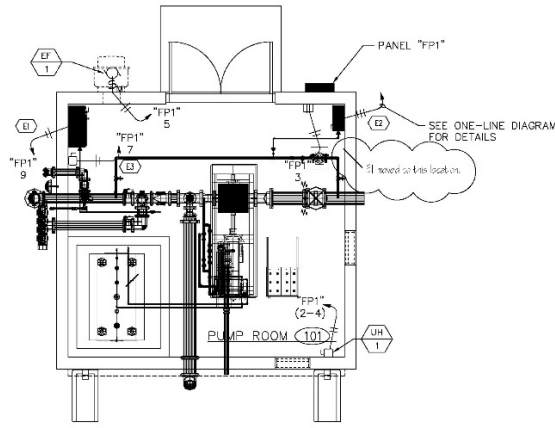

1 POWER PLAN  
 1/4"=1'-0"

**ELECT. EQUIP. REQUIREMENTS**

- ELECTRICAL CONTRACTOR SHALL PROVIDE CORRECT SIZE/TYPE/VOLTAGE/QUANTITY OF DUAL-ELEMENT, TIME-DELAY FUSE(S) SIZED PER EQUIPMENT MANUF. UNLESS OTHERWISE SPECIFIED BY UNIT NAMEPLATE/MANUFACTURER DATA.
- ALL FEEDERS SHALL BE IN ACCORDANCE WITH THE ELECTRICAL SYSTEM SPEC'S (3.2).
- COORDINATE EXACT LOCATIONS OF ALL EQUIPMENT PRIOR TO ROUGH-IN.

LABEL	VOLTS/A	FJA	BRANCH CIRCUIT	CONNECTION TYPE	CONDUCTORS/ CONDUIT
(E1) PUMP CONTROLLER	120/1	10	PANEL CIRCUIT "TPI" 9	PROVIDE MEANS OF DISCONNECT IF NOT INTEGRAL WITH PUMP CONTROLLER	(2) #12 Cu. (1) #12 Cu. E.G. = 3/4" C.
(E2) JOCKEY PUMP CONTROLLER	480/3	4.5	PANEL CIRCUIT FLUORE	PROVIDE MEANS OF DISCONNECT IF NOT INTEGRAL WITH PUMP CONTROLLER	(3) #12 Cu. (1) #10 Cu. E.G. = 3/4" C.
(E3) PUMP BLOCK HEATER	120/1	8.3	PANEL CIRCUIT "TPI" 7	HEAVY DUTY 30AMP 250V 1P/1F NEMA 3R DISC. SWITCH	(2) #12 Cu. (1) #12 Cu. E.G. = 3/4" C.

**HVAC ELECT. REQUIREMENTS**


- ELECTRICAL CONTRACTOR SHALL PROVIDE CORRECT SIZE/TYPE/VOLTAGE/QUANTITY OF DUAL-ELEMENT, TIME-DELAY FUSE(S) SIZED PER HVAC EQUIPMENT MANUFACTURER UNLESS OTHERWISE SPECIFIED BY UNIT NAMEPLATE/MANUFACTURER DATA.
- ALL CONDUCTORS SHALL BE IN ACCORDANCE WITH THE ELECTRICAL SYSTEM SPEC'S (3.2). ALL TAP CONDUCTORS SHALL MEET THE REQUIREMENTS OF NEC ARTICLE 310.10(B)(2).
- PROVIDE MAGNETIC MOTOR STARTER WITH THERMAL OVERLOAD PROTECTION, (2) AUXILIARY CONTACT SWITCHES, INTERNAL LINE VOLTAGE TO 24 VOLT TRANSFORMER (250VA MIN) WITH PROPER PRIMARY/SECONDARY PROTECTION, AMBIENT COMPENSATED, RED RUNNING LIGHT, HAND-OFF-AUT. ACROSS THE LINE STARTERS TO 25HP, WILL BE PROVIDED WITH EACH MOTOR ON THE DRAWINGS (ONE HORSEPOWER TO 25 H.P.).

UNIT	VOLTS/A	FULL LOAD AMPS	DISCONNECTING MEANS	CONDUCTORS/ CONDUIT
(UH 1)	240/1	3	HEAVY DUTY 60AMP 250V 1P/1F NEMA 3R DISCONNECT SWITCH	(2) #12 Cu. (1) #12 Cu. E.G. = 3/4" C.

Notes: UH1 called for 480V 3 phase. This power was not available. Switched to 200V and (2) #10 Cu. 3/4".

**GENERAL NOTES – LIGHTING**

- REFER TO ELECTRICAL SPECIFICATIONS FOR ADDITIONAL REQUIREMENTS AND COMPLETE CONTRACTUAL OBLIGATIONS.
- THE ELECTRICAL CONTRACTOR SHALL (PRIOR TO HIS BID) VISIT THE SITE AND FIELD VERIFY ALL EXISTING CONDITIONS AND TAKE ALL CONSIDERATIONS INTO ACCOUNT AT THE TIME OF BIDDING. NO ADDITIONAL CONSIDERATIONS WILL BE GRANTED THE CONTRACTOR AFTER THE BID IS ACCEPTED.
- ALL ELECTRICAL METALLIC TUBING (EMT), RIGID NON-METALLIC CONDUIT, FLEXIBLE METALLIC CONDUIT, FLEXIBLE NON-METALLIC CONDUITS, "SEALTIGHT" TYPE CONDUITS AND ALL OTHER CONDUITS THAT DO NOT CONTAIN A CODE SIZED GROUND WIRE SHALL HAVE A CODE SIZED BOND WIRE INSTALLED WITH THE CIRCUIT CONDUCTORS.
- ALL NIGHT/LIGHT/EMERGENCY LIGHT (NL/ELM) FIXTURES SHALL BE CONNECTED UNSWITCHED. IF NO EMERGENCY LIFE SAFETY SYSTEM IS INSTALLED (EG GENERATOR, etc.), THE OUTER LAMPS SHALL BE CONNECTED UNSWITCHED TO LOCAL LIGHTING CIRCUIT AND CONNECTED VIA AN EMERGENCY BALLAST - 1400 LUMEN OR FULL LUMEN OUTPUT MINIMUM. PROVIDE NEW IF NOT ALREADY EXISTING.
- ALL FIXTURES INSTALLED OUTDOORS SHALL BE RATED FOR DAMP/WET LOCATIONS AS REQUIRED. THE CONTRACTOR SHALL COORDINATE DAMP/WET LOCATION RATING AND INSTALLATION PER NEC ARTICLE "FIXTURE LOCATIONS".
- ALL RECESSED LIGHT FIXTURES SHALL BE I.C. RATED OR A MINIMUM OF 3" FROM COMBUSTIBLE MATERIAL PER NEC ARTICLE "LUMINAIRES, LAMP HOLDERS AND LAMPS - CLEARANCE AND INSTALLATION".
- ELECTRICAL CONTRACTOR TO VERIFY A MINIMUM OF 1 FOOT-CANDLE AT 1 FOOT ABOVE FLOOR ALONG EXIT PATH PER IBC ARTICLE "MEANS OF EGRESS ILLUMINATION".
- LIGHT SWITCHES SHALL BE INSTALLED TO CONFORM TO NEC ARTICLE "SWITCHES - ACCESSIBILITY AND GROUPING".
- ALL INDOOR FLUORESCENT FIXTURES WITH DOUBLE ENDED LAMPS SHALL HAVE INTEGRAL DISCONNECTS.

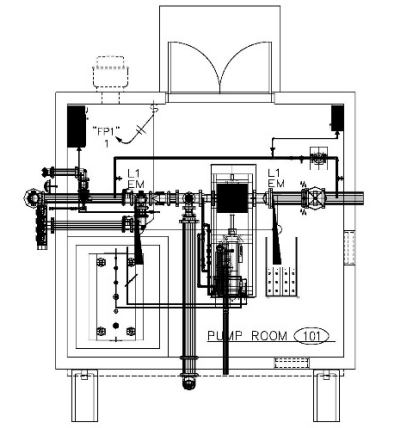

2 LIGHTING PLAN  
 1/4"=1'-0"

**LUMINAIRE SCHEDULE**

- PROVIDE 90 MINUTE EMERGENCY BATTERY BALLAST FOR ALL EMERGENCY FIXTURES. SEE SCHEDULE BELOW FOR SPECIFICATIONS AND LUMEN REQUIREMENTS.
- MODULAR WIRING SYSTEM FOR LIGHT FIXTURES IS AN ACCEPTABLE ALTERNATE.
- BASE BID FOR LUMINAIRES SHALL BE BASED ON MANUFACTURERS LISTED IN CONTRACT DOCUMENTS. UPON AWARD OF PROJECT, ALTERNATES PROPOSED BY CONTRACTOR SHALL BE SUBMITTED WITH WRITTEN OWNER APPROVAL & AN ITEMIZED SCHEDULE TO BASE BID.
- ALTERNATE FIXTURE SELECTIONS MAY REQUIRE ADDITIONAL TIME FOR SUBMITTAL REVIEW & POSSIBLE ENGINEERING DESIGN CHANGES, TO BE BILLED TO THE CONTRACTOR.
- PROVIDE MINIMUM 10 MINUTE TIME DELAY ON EMERGENCY FIXTURES WHEN HD AREA LIGHTING IS USED.

**EMERGENCY BALLAST SCHEDULE**

LAMP TYPE	MANUFACTURER MODEL NUMBER	MINIMUM LUMENS	# OF LAMPS	LAMP TYPE	MANUFACTURER MODEL NUMBER	MINIMUM LUMENS	# OF LAMPS
13W CFL	BOCNE B840 OR EQUAL	650	1	17W T8	BOCNE B50 OR EQUAL	1050	1
18W CFL	BOCNE B840 OR EQUAL	850	1	32W T8	BOCNE B50 OR EQUAL	1350	1
26W CFL	BOCNE B840 OR EQUAL	750	1	14W T5	BOCNE L9600 OR EQUAL	750	1
15W CFL	BOCNE B840 OR EQUAL	650	1	28W T5	BOCNE L9600 OR EQUAL	1250	1
42W CFL	BOCNE B840 OR EQUAL	1000	1	54W T5	BOCNE L9600 OR EQUAL	2500	2

MARK	MANUFACTURER MODEL NUMBER	VOLTS	LAMPS OR/ECT INPUT WATTS	REMARKS/MOUNTING
L1	LITHONIA DWK-25-12-SE-0P5 EL140W-P67	120	2-28W T5 4000 50W	WET LOCATION SURFACE MOUNT STRIP WITH 2 LAMPS

**OWNERSHIP OF DOCUMENTS**  
 This document is the property of Heritage Environmental Services, LLC. It is to be used only for the project and site identified herein. It is not to be reproduced, stored in a retrieval system, or transmitted in any form or by any means, electronic, mechanical, photocopying, recording, or by any information storage and retrieval system, without the prior written permission of Heritage Environmental Services, LLC. © 2014 All rights reserved.

**HOLDEN DESIGN ASSOCIATES, LLC**  
 5470 S LAKESHORE DR. SUITE 104 TEMPE, ARIZONA 85283  
 480-897-7145 FAX 480-897-7145 710brchitects@holden-az.com

**ELECTRICAL POWER/LIGHTING PLAN**

**HERITAGE ENVIRONMENTAL SERVICES - PUMP HOUSE**  
 294 E. STONEY ROAD  
 COCHISE, ARIZONA 85528



JOB: 1402  
 DATE: 3/14  
**SHEET E-1**

**AS-BUILD**

Project Contact/Designer: **KERRY LEONARD**  
 Project #14104  
**HAWKINS DESIGN GROUP, INC.**  
 ELECTRICAL ENGINEERS  
 252 SOUTH VINEYARD AVE. SUITE 107  
 TUCKER, GEORGIA 30084  
 P: 480.813.9550 F: 480.813.9001  
 EMAIL: em@hwdg.com

PRELIMINARY NOT FOR CONSTRUCTION  
 Expires: 09/30/14

P:\L024030\Draw\Sheets\The Pump House\DWG\24MW2016.dwg DATE: 03/26/14 TIME: 10:15

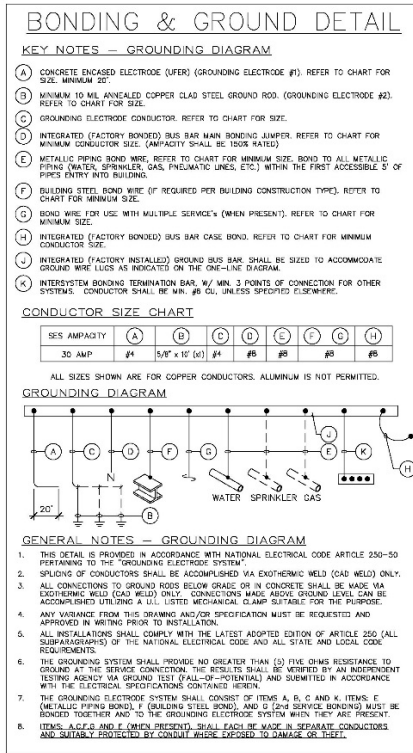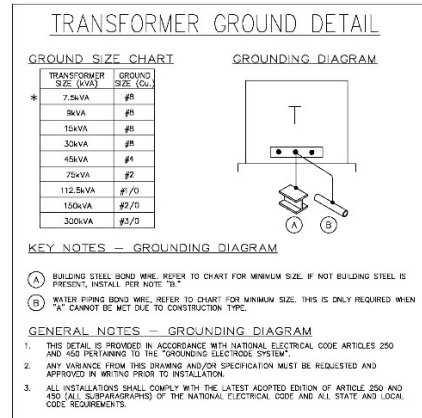

### NEW PANELBOARD SCHEDULE "FP1"

TYPE	PANELBOARD	NEA TYPE	NEA 3R	MAIN TYPE	M.G.B.
VOLTAGE	240/120V 1Ø 3W	AF	<18k	FED 750V	NO
MOUNTING SURFACE	3Ø	C/S BATH	FULLY RATED	SEE GROUND	NO
LOAD TAKEN AT 125% BUS AMPS	3Ø	C/S ALL	18,000	SERVICE RATED	YES

LOAD TAKEN AT 125% \* PROVIDE THE BAR EXIST. TO REMAIN UNCHANGED □  
 HANDLE "LOCK-OUT" DEVICE ○ CREDIT VIA LIG CONTROLS ◇ EXIST. WITH CHANGED LOAD □  
 HANDLE "LOCK-OUT" DEVICE ○ EXIST. W/ ALL LOAD REMOVED ◇ NEW BREAKER WITH NEW LOAD △  
 R = RECEIPTS H = H.V.A.C. E = EQUIP. K = KITCHEN M = MISC. L = CONT. LIGHTING C = CONT. EQUIP.

TYPE	AREA SERVED	C/W	#	AMP	Ø#	C/W	TYPE	AREA SERVED
L	LIGHTS	20'	12	1000	Ø2	70	H	HEATER
R	RECEPTACLE	20'	24	1000	Ø4	2		
H	EXHAUST FAN	20'	12	200	Ø2			-BUSSED SPACE
E	CRANKCASE HEATER	20'	12	1000	Ø4			-BUSSED SPACE
E	FIRE PUMP CONTROLLER	20'	3	1000	Ø4			-BUSSED SPACE
	- SPARE	20'	12		Ø4			-BUSSED SPACE
	NON-CONTINUOUS LOAD		2800	2500	2800	VA / 120 V =		24.2 AMPS
	CONTINUOUS LOAD @ 25%		112	0	112	VA / 120 V =		0.5 AMPS
	CONTINUOUS LOAD @ 25%		28	0	28	VA / 120 V =		0.2 AMPS
	TOTAL LOAD PER PHASE		3040	2580	3040	VA / 120 V =		25.3 AMPS

- ### GENERAL NOTES - ONE-LINE
- THE ELECTRICAL CONTRACTOR SHALL FIELD VERIFY ALL EXISTING CONDITIONS TO FULLY FAMILIARIZE HIMSELF WITH ALL EXISTING CONDITIONS PRIOR TO BID. NO ADDITIONAL CONSIDERATIONS WILL BE ALLOWED AFTER THE BID.
  - THE ELECTRICAL CONTRACTOR IS RESPONSIBLE FOR INSTALLING ALL INDICATED EQUIPMENT TO CODE COMPLIANT CLEARANCES. PROVIDE SUBMITTALS AS INDICATED IN SPECIFICATIONS TO PROPERLY COORDINATE PHYSICAL LOCATIONS OF NEW AND/OR EXISTING EQUIPMENT.
  - REFER TO ELECTRICAL SPECIFICATIONS FOR ADDITIONAL REQUIREMENTS AND COMPLETE CONTRACTUAL OBLIGATIONS.
  - ALL DASHED LINES ARE INDICATING EXISTING EQUIPMENT.
  - THE ELECTRICAL CONTRACTOR SHALL PROVIDE FOR AND COORDINATE ALL TESTING AND INSPECTIONS REQUIRED BY THE AUTHORITY HAVING JURISDICTION, AND SHALL PROVIDE WRITTEN REPORTS TO THE ENGINEER OF ALL TEST RESULTS AND INSPECTION REPORTS FOR THIS DISCIPLINE.
  - UPON SUBSTANTIAL COMPLETION, THE ELECTRICAL CONTRACTOR SHALL NOTIFY THE ENGINEER AND SHALL ALLOW, AT THE ENGINEER'S DISCRETION, FOR THE INSPECTION OF NEW WORK PRIOR TO ENERGIZING.


### LOAD SUMMARY

CONNECTED LOAD ON PANEL "FP1"	=	5720 VA
CONNECTED LOAD ON JOCKEY PUMP CONTROLLER	=	1825 VA
TOTAL REVISED LOAD ON FUTURE PANEL	=	7545 VA

### COPPER CONDUCTOR/CONDUIT SCHEDULE

NOTE: NOT ALL CONDUCTOR SIZES MAY BE USED.

TAC	CONDUCTOR/CONDUIT
3.40	(3) #8's Cu., (1) #10 Cu. E.G. - 3/4" C.
3.30	(3) #10's Cu., (1) #10 Cu. E.G. - 3/4" C.

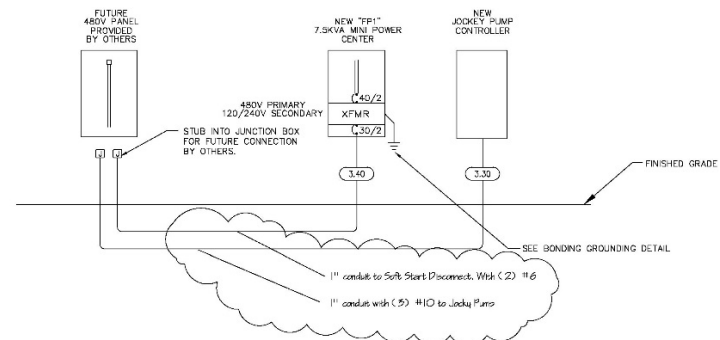

**OWNERSHIP OF DOCUMENTS**  
 This document is the property of Heritage Environmental Services, LLC. The design and drawings incorporated herein are the sole property of Heritage Environmental Services, LLC and are not to be reproduced, changed, or used by anyone in whole or in part, for any other project without written permission of Heritage Environmental Services, LLC. © 2014 All rights reserved.

HERITAGE ENVIRONMENTAL SERVICES, LLC  
 5470 S. LAKESHORE DR. SUITE 104 TEMPE, ARIZONA 85283  
 480-897-7145 480-897-7145  
 heritagedesig@hse.com

ELECTRICAL ONE-LINE DIAGRAM AND PANEL SCHEDULE

HERITAGE ENVIRONMENTAL SERVICES, LLC  
 284 F STREET ROAD  
 COOHIK, ARIZONA 85126

JOB: 1402  
 DATE: 3/14  
 SHEET E-2

AS-BUILD

PRELIMINARY NOT FOR CONSTRUCTION  
 Expires: 09/30/11

Project Contact/Designer: KERRY LEONARD  
 Project #14104  
**HAWKINS DESIGN GROUP INC.**  
 ELECTRICAL CONSULTING ENGINEERS  
 252 SOUTH VINEYARD AVE. SUITE 107  
 MESA, ARIZONA 85205  
 PH: 480.813.9500 FAX: 480.813.9001  
 EMAIL: kerry@hawkinsdg.com

P:\005\JBE Const Services\2014\02\1402.dwg DATE: 03/09/14 TMC 10:15



- GENERAL NOTES - SITE**
1. REFER TO ELECTRICAL SPECIFICATIONS FOR ADDITIONAL REQUIREMENTS AND COMPLETE CONTRACTUAL OBLIGATIONS.
  2. ELECTRICAL CONTRACTOR SHALL CONTACT TELEPHONE COMPANY REGARDING EXACT LOCATION OF ALL PRIMARY SERVICE EQUIPMENT, TRENCH LOCATION, ETC.
  3. ELECTRICAL CONTRACTOR SHALL PROVIDE ALL NECESSARY TELEPHONE TRENCHING, BACKFILL, AND CONDUIT SLABS IN/TD TRENCH AS REQUIRED BY TELEPHONE COMPANY AND TO THEIR SPECIFICATIONS.
  4. ALL WIRING FOR OUTSIDE LIGHTING SHALL BE A MINIMUM OF #10 COPPER WITH TYPE THWN INSULATION. RUN UNDERGROUND CIRCUITS IN P.V.C. AND PROVIDE A #10 COPPER BOND IN ADDITION TO CIRCUIT CONDUCTORS. UNDERGROUND WIRING SHALL COMPLY WITH APPLICABLE CODES OF THE NEC.
  5. ELECTRICAL CONTRACTOR SHALL PROVIDE NECESSARY SECONDARY CONDUCTORS, POWER TRENCHING, BACKFILL, AND CONCRETE PADS FOR TRANSFORMERS AND SERVICE EQUIPMENT. ADDITIONALLY PROVIDE CONDUIT STUBS INTO TRENCH PER POWER COMPANY SPECIFICATIONS AND REQUIREMENTS.
  6. ALL WIRING SHALL BE COPPER. WIRING #4 AWG AND LARGER SHALL BE XHHW TYPE INSULATION.

- KEYED NOTES**
- ① FUTURE ABOVE PANEL TO BE INSTALLED BY OTHERS.
  - ② MINI POWER CENTER, "FP1" SEE ONE-LINE DIAGRAM FOR DETAILS.


**OWNERSHIP OF DOCUMENTS**  
 This Document is the intellectual property of Hawkins Design Associates, LLC and is not to be reproduced, altered or used in whole or in part, for any other project without written permission of Hawkins Design Associates, LLC © 2014. All rights reserved.

**HAWKINS DESIGN ASSOCIATES, LLC**  
 5470 S LAKESHORE DR., SUITE 104 TEMPE, ARIZONA 85283  
 480-897-7745 FAX 480-897-7108 architects@hds-az.com

**ELECTRICAL SITE PLAN**

**HERITAGE ENVIRONMENTAL SERVICES FRI-PUMP HOUSE**  
 2841 1-STORY ROAD  
 CANTON, ARIZONA 85725

JOB: 1402  
 DATE: 3/14  
 SHEET ES-1

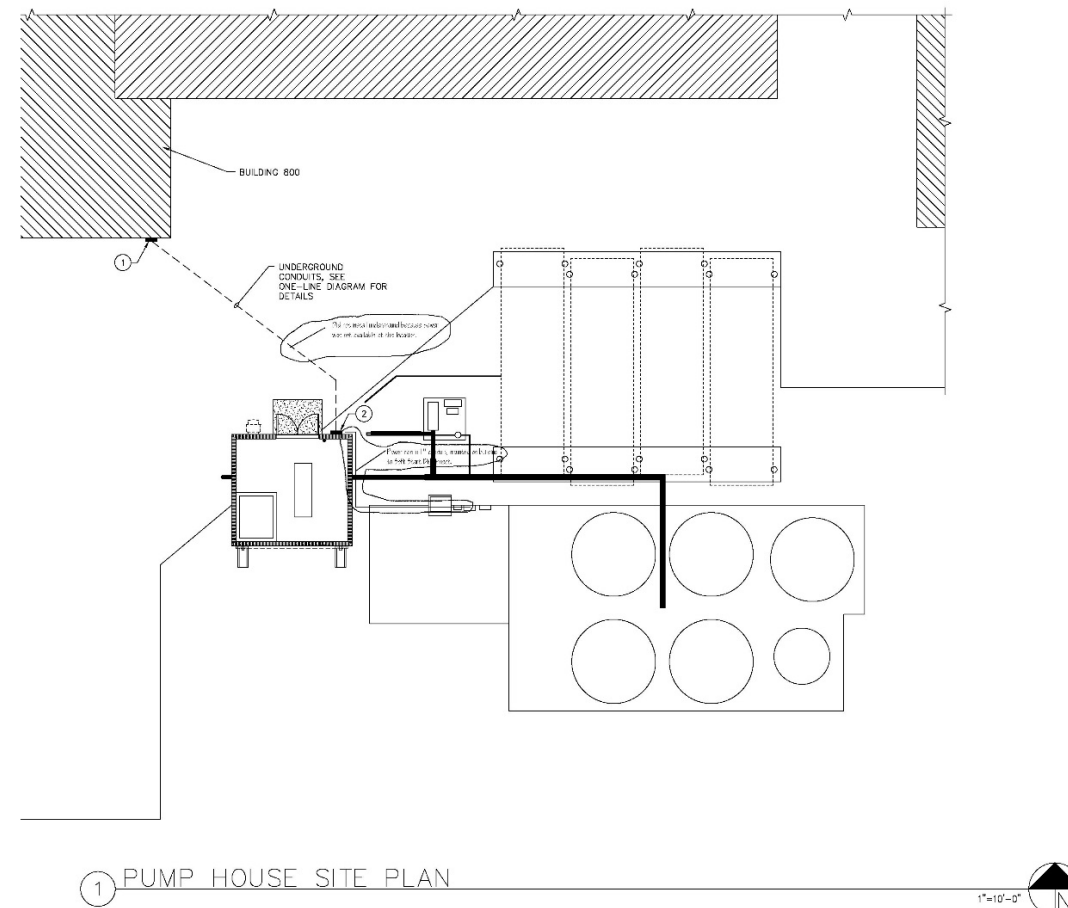

**AS-BUILD**

PRIOR TO ANY GROUND EXCAVATION CALL BLUE STAKE  
 (602) 263-1100  
 (800) 782-5348


PRELIMINARY NOT FOR CONSTRUCTION  
 Expires: 08/30/14

Project Contact/Designer: KERRY LEONARD  
 Project #14104  
**HAWKINS DESIGN GROUP INC.**  
 ELECTRICAL CONSULTING ENGINEERS  
 252 SOUTH WINEYARD AVE., SUITE 107  
 MESA, ARIZONA 85202  
 PH: 480.897.3500 FAX: 480.897.3500  
 EMAIL: info@hdsinc.com

P:\VIBS\306\Conti\_Sen\VIS File Pump House\CON\A21.dwg DATE: 03/09/14 TIME: 10:15

**AS-BUILT ALARM AND DETECTORS**

SHEET SIZE 36X24

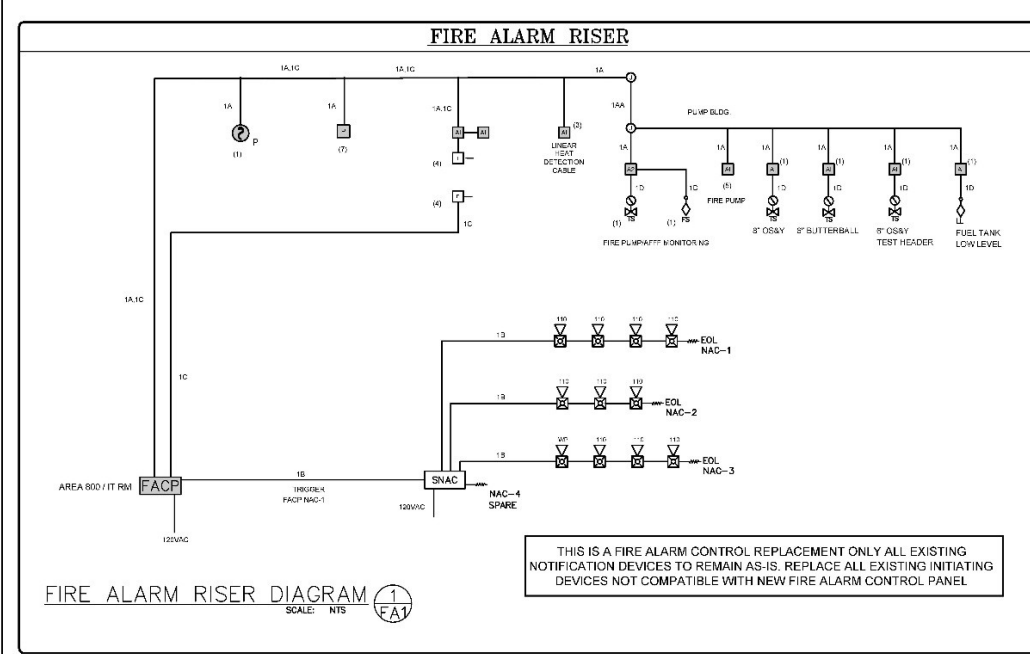

**FIRE ALARM GENERAL NOTES**

THE NEW FIRE ALARM CONTROL PANEL SHALL BE INSTALLED IN STRICT ACCORDANCE WITH THE SPECIFIC STANDARDS APPROVED BY THE AUTHORITY HAVING THE JURISDICTION.

ALL EXISTING WIRING SHALL BE UTILIZED TO TIE-IN ALL EXISTING NAC CIRCUITS AND INITIATING CIRCUITS TO THE NEW FIRE ALARM CONTROL PANELS.

ALL EXISTING FIRE ALARM NOTIFICATION DEVICES SHALL REMAIN AS-IS UNLESS NOTED OTHERWISE

REPLACE ANY INITIATING DEVICE NOT COMPATIBLE WITH NEW FIRE ALARM CONTROL PANEL WITH A NEW ADDRESSABLE INITIATING DEVICE (FIELD VERIFY)

PROVIDE/INSTALL MONITOR MODULES TO MONITOR EACH FIRE SPRINKLER WATER FLOW SWITCH ALARM AND TAMPER SWITCH SUPERVISORY.

THE NEW FIRE ALARM EQUIPMENT SHALL BE INSTALLED THAT ACCIDENTAL OPERATION OR FAILURE IS NOT CAUSED BY VIBRATION, JARRING OR TAMPERING.

ALL SPLICES OF WIRE SHALL BE MECHANICALLY CONNECTED TAPED OR INSULATED AND BE FREE OF ANY CONDUIT OR GROUND FAULTS.

A FULL FUNCTION TEST SHALL BE PERFORMED WITH THE NEW FIRE ALARM DEVICES AND THE EXISTING DEVICES TO ASSURE PROPER OPERATIONS PRIOR TO FINAL INSPECTION WITH THE LOCAL AUTHORITY HAVING JURISDICTION.

ALL EXISTING NAC CIRCUITS SHALL BE TESTED FOR INTEGRITY AND VOLTAGE DROP.

PRIOR TO ANY WORK BEEN STARTED A SET OF APPROVED PLANS SHALL BE KEPT AT THE JOB SITE AT ALL TIMES.

INSTALLING CONTRACTOR SHALL BE RESPONSIBLE TO COORDINATE ALL TESTING WITH LOCAL AUTHORITY HAVING JURISDICTION, GENERAL CONTRACTOR, AND ANY ASSOCIATED CONTRACTORS.

**WIRE CHART**

WIRE SCHEDULE

CODE	DESCRIPTION / FUNCTION	PART #
A	2018 TW JACKETED PAIR, SLC LOOP, MID-CAPACITANCE	BEULDEN - 8220AL
B	2014L HORN/STROBE OR NAC TRIGGER CKL'S	BEULDEN - 8220AL
C	2018L POWER OR AUX. CONNECTION	BEULDEN - 8220AL
D	2018L MODULE INITIATION CKT.	BEULDEN - 8220AL
E	2018L TW SH. PLS. SYSTEM BUS	BEULDEN - 8224H
AA	NET LOCATION, 2018 TW JACKETED PAIR, SLC LOOP	WEST PENN - A0225
CC	NET LOCATION, 2018L POWER OR AUX. CONNECTION	WEST PENN - A0225
DD	NET LOCATION, 2018L MODULE INITIATION CKT.	WEST PENN - A0225
EE	NET LOCATION, 2018L TW SH. PLS. SYSTEM BUS	WEST PENN - A0224

WIRING TO MEET NEC 780 STANDARDS

**FIRE ALARM SYMBOLS**

QTY	SYMBOL	DESCRIPTION	MANUFACTURE	MODEL NUMBER
1	FACP	FIRE ALARM CONTROL PANEL	FIRELITE	MS920UDLS
2	BATT	BATTERIES	-	DV 12AH
1	FAAP	FIRE ALARM ANNUNCIATOR	FIRELITE	LCD-80P
1	SNAC	AUXILIARY POWER BOOSTER	FIRELITE	FCPS-1-050
1	BATT	BATTERIES	-	DV 12AH
1	PSD	PHOTOELECTRIC SMOKE DETECTOR	FIRELITE	SD500
7	MS	MANUAL PULL STATION	FIRELITE	BS-2LX
22	AMM	ADDRESSABLE MONITOR MODULE	FIRELITE	MFP-301
1	ADM	ADDRESSABLE DUAL MONITOR MODULE	FIRELITE	MDF-300
1	WFS	WATER FLOW SWITCH CONNECTION	-	-
1	TSC	TAMPER SWITCH CONNECTION	-	-
1	WMS	WALL MOUNT HORN/STROBE	SYSTEM SENSOR	M2K
1	BSM	BEAM SMOKE DETECTOR	FIRELITE	BSAP1000

QUANTITIES APPLY ONLY TO NEW DEVICES LOCATED IN THE SCOPE OF WORK. NOT ALL SYMBOLS MAY APPLY TO THIS PROJECT (SEE FIRE ALARM RISER)

**DEVICE ANNOTATIONS**

R - RELOCATE/RE-USE EXISTING FIRE ALARM DEVICE AT NEW LOCATION AS SHOWN  
 D - DEMO EXISTING FIRE ALARM DEVICE  
 X - EXISTING FIRE ALARM DEVICE SHALL REMAIN AS-IS UNLESS NOTED OTHERWISE  
 RP - REPLACE THE EXISTING FIRE ALARM DEVICE UTILIZING EXISTING WIRING LOCATION

S4-02 = NAC CROBT - DEVICE WIRING    MF = NOTERPROOF    S-10 = SLC/DC CIRCUIT - DEVICE WIRING

**FACP REPLACEMENT**

THIS IS A FIRE ALARM CONTROL PANEL REPLACEMENT ONLY ALL DEVICES ARE EXISTING TO REMAIN AS-IS NO CHANGE. THE FIRE ALARM LAYOUT IS BASED ON THE INFORMATION PROVIDED BY INSTALLING CONTRACTOR TO ARCS DESIGN GROUP

**SCOPE OF WORK**

THE NEW FIRE ALARM CONTROL REPLACEMENT SHALL CONSIST OF, BUT NOT LIMITED TO THE FOLLOWING:

- REPLACE EXISTING FIRE ALARM CONTROL PANEL WITH A FIRELITE MS-920UDLS FIRE ALARM CONTROL PANEL WITH BATTERY BACK UP AND BUILT IN DIGITAL COMMUNICATOR UTILIZING ALL EXISTING WIRING AND FIRE ALARM DEVICES (MONITORED BY A CENTRALLY LOCATED MONITORING STATION)
- PROVIDE/INSTALL MONITOR MODULES TO MONITOR ALL EXISTING WATER FLOW AND TAMPER SWITCHES IN EACH BUILDING.
- ALL EXISTING FIRE ALARM STROBES ONLY AND HORN/STROBES TO REMAIN AS-IS
- PROVIDE/INSTALL MONITOR MODULES AS NEEDED TO MONITOR THE EXISTING INITIATING CIRCUITS IN THE BUILDING.
- PROVIDE/INSTALL DUAL MONITOR MODULE TO MONITOR THE FIRE SPRINKLER WATER FLOW ALARM AND TAMPER SWITCH SUPERVISORY
- REPLACE ANY INITIATING DEVICE NOT COMPATIBLE WITH NEW FIRE ALARM CONTROL PANEL WITH A NEW ADDRESSABLE INITIATING DEVICE (FIELD VERIFY)
- Dedicated circuit to the fire alarm control panel, provided by others
- TWO (2) PHONE LINES ONE (1) DEDICATED AND ONE (1) SECONDARY BACK LINE LEISURE, PROVIDED BY OTHERS, IF NOT EXISTING
- TEST ALL EXISTING NAC CIRCUITS FOR INTEGRITY WITH NEW FIRE ALARM CONTROL PANEL.
- A VOLTAGE DROP TEST SHALL BE CONDUCTED IN FIELD FOR ALL EXISTING NAC CIRCUITS.

**INSTALLING COMPANY:**

NAME: A & J FIRE PROTECTION  
 ADDRESS: P.O. BOX 82292  
 PHOENIX, AZ 85071  
 PHONE: 602-344-7156  
 AZ REG. C-16 268054

**TYPE OF SYSTEM:**

FIRE ALARM SYSTEM  
 LOCAL PROTECTIVE OFFSITE MONITORING  
 DIGITAL ADDRESSABLE NOTIFICATION CLASS B WIRING  
 SLC STYLE "6" WIRING  
 TEMPORAL SOUNDING STROBES  
 POWER LIMITED SYSTEM  
 FREE AIR CABLE

**CODES & STANDARDS:**

IBC 2012  
 IFC 2012  
 IMC 2012  
 NEC 2011  
 NFPA 72 2010

**BUILDING OCCUPANCY:**

GROUP "B" - LAB TESTING ORGANIC RESEARCH  
 FULLY SPRINKLERED

**SQUARE FOOTAGE:**

TOTAL: 18,500 SQ FT

**APPROVING AGENCY (S)**

NAME: STATE FIRE MARSHAL  
 ADDRESS: 1100 WEST WASHINGTON RD, SUITE 1000  
 PHOENIX, AZ 85001  
 PHONE: 602-364-1025

HERITAGE ENVIRONMENTAL SERVICES, LLC, COOLIDGE AZ

**BATTERY BACK UP CALCULATIONS**

**FIRELITE MS-920UDLS Battery Calculation**

Regulated Load in Standby			
Device Type	Number of Devices	Current (Amps)	Total Current (Amps)
Main Circuit Board	1	0.255000	0.255000
IPDACT	1	0.100000	0.100000
LCD-80P	0	0.025000	
<b>Addressable Devices</b>			
SC355	1	0.000300	0.000300
11355	0	0.000300	
MWF-300	22	0.000400	0.008800
MWF-300	1	0.000750	0.000750
MWF-301	0	0.000375	
BS-12LX	7	0.000230	0.001610
CMF-300	0	0.000390	
CRP-300	0	0.000270	
Current Draw from TB3 (nonalarm)	0	0.000000	
<b>Total Standby Load</b>			<b>0.371460</b>
Regulated Load in ALARM			
Device Type	Number of Devices	Current (Amps)	Total Current (Amps)
Main Circuit Board	1	0.325000	0.325000
IPDACT	1	0.300000	0.300000
LCD-80P	0	0.064000	
ALL Addressable Devices - Maximum draw	1	0.400000	0.400000
NAC #1	0	0.000000	
NAC #2	0	0.000000	
NAC #3	0	0.000000	
NAC #4	0	0.000000	
Current Draw from TB3 (nonalarm)	0	0.000000	
<b>Total Alarm Load</b>			<b>1.036000</b>
<b>Required Standby Time in Hours (24 or 60 Hrs.)</b>			
Standby Load Current (Amps)	0.371460	x	24
			<b>= 8.915 AH</b>
<b>Required Alarm Time in Hours (5 minutes = 0.084)</b>			
Alarm Load Current (Amps)	1.036000	x	0.084
			<b>= 0.087 AH</b>
<b>Total Current Load</b>			
			<b>9.002 AH</b>
Multiply by the Derating Factor 1.2			
			<b>= 10.802 AH</b>
<b>Total Ampere Hours Required</b>			
			<b>10.802 AH</b>

NOTE: TWO (2) 12V 12AH BATTERIES USED WITH THE FIRE ALARM CONTROL PANEL

THIS IS A FIRE ALARM CONTROL REPLACEMENT ONLY ALL EXISTING NOTIFICATION DEVICES TO REMAIN AS-IS THEREFOR NO VOLTAGE DROP CALCULATIONS HAVE BEEN PROVIDED

**SEQUENCE OF OPERATION**

INPUTS & ACTIONS	FACP TROUBLE CONDITION	BATTERY FAULT	GROUND FAULT	OPEN CIRCUIT	LOSS OF PRIMARY POWER	SMOKE DETECTOR IN ALARM	REMOTE MANUAL PULL STATION	FIRE SPRINKLER WATER FLOW SWITCH	FIRE SPRINKLER TAMPER SWITCH	FIRE PUMP RUNNING	FIRE PUMP TROUBLE	FIRE PUMP DISABLED
OPERATE AREA EVACUATION SIGNALS (TEMPORAL CODE 3)												
INDICATE ZONE/DEVICE AT FACP & FAAP												
SEND ALARM SIGNAL TO CENTRAL MONITORING STATION												
SEND TROUBLE SIGNAL TO CENTRAL MONITORING STATION												
SEND SUPERVISORY SIGNAL TO CENTRAL MONITORING STATION												
SEND WATERFLOW SIGNAL TO CENTRAL MONITORING STATION												
ILLUMINATE LED ON SMOKE DETECTOR												

NOTE: THE SEQUENCE OF OPERATION REFLECTS WHAT IS IN THE SCOPE OF WORK ONLY

**APPROVAL STAMP**

OFFICE OF THE STATE  
 FIRE MARSHAL

02/02/2017

Approval is not to be construed as an  
 Approval of any violation of the  
 Arizona Fire Code

Permit 17-549 FA  
 See Notes On Permit

**ARCS DESIGN GROUP**

ARCSdesigngroup.com  
 Phone: (602) 225-6005  
 email: cs@arcsdesigngroup.com  
 \*FOR ALL OF YOUR FIRE ALARM DESIGN NEEDS\*

Project Name and Address

284 EAST STOREY RD  
 COOLIDGE, AZ

HERITAGE ENVIRONMENTAL SERVICES, LLC

ENGINEERING TECHNICIAN  
 FIRE ALARM SYSTEMS  
 CERTIFICATION # 103885  
 N.I.C.E.T. III  
 VALID THRU 10/10/2019  
 ART CRUZ DET  
*Art Cruz*

Installing Contractor

A & J  
 FIRE PROTECTION  
 P.O. BOX 82082  
 PHOENIX, ARIZONA 85071  
 OFFICE PHONES: (602) 344-7788  
 FAX: (602) 344-8664

Drawn  
 AC

Job Number  
 17-054

Date  
 30 JANUARY 2017

Scale  
 AS NOTED

Sheet Number  
**FA1**

OF: TWO

ENGINEER SHALL NOT BE RESPONSIBLE FOR CONTRACTOR'S FAILURE TO PERFORM THE WORK IN ACCORDANCE WITH THE CONTRACT DOCUMENTS

01-30-2017


AC

SHEET SIZE 30X24

HERITAGE ENVIRONMENTAL SERVICES, LLC, COOLIDGE AZ

01-30-2017 AC

Zones	
Zone	Description
1	SMOKE DETECTOR ABOVE FACP
1	600 NORTH Pull
2	600 SOUTH Pull
3	600 WEST Pull
4	800 SOUTH Pull
5	800 EAST Pull
6	800 WEST Pull
7	600 Beam Det Alarm
8	600 Beam Det Trouble
9	600 Beam Det Alarm
10	600 Beam Det Trouble
11	800 Beam Det Alarm
12	800 Beam Det Trouble
13	800 Beam Det alarm
14	800 Beam Det trouble
15	600 FOAM WATERFLOW
16	600 FOAM VALVE OUTSIDE
17	FIRE PUMP DISABLED
18	FIRE PUMP FAULT
19	FIRE PUMP RUNNING
20	FUEL TANK LOW
21	PUMP HOUSE FIRE SPRINKLER
22	PUMP HOUSE SPRINKLER VALVE
23	PUMP HOUSE 8" O&M
24	PUMP HOUSE BUTTERBALL VALVE
25	JOCKEY PUMP VALVE EAST
26	JOCKEY PUMP VALVE WEST
27	PUMP HOUSE TEST HEADER
28	FOAM SYSTEM HEADER
30	LOBBY Pull
31	LOADING DOCK - REAR OF BUILDING Pull
32	CANOPY THERMO CABLE
33	TRUCK THERMO CABLE
34	RAIL CAR THERMO CABLE

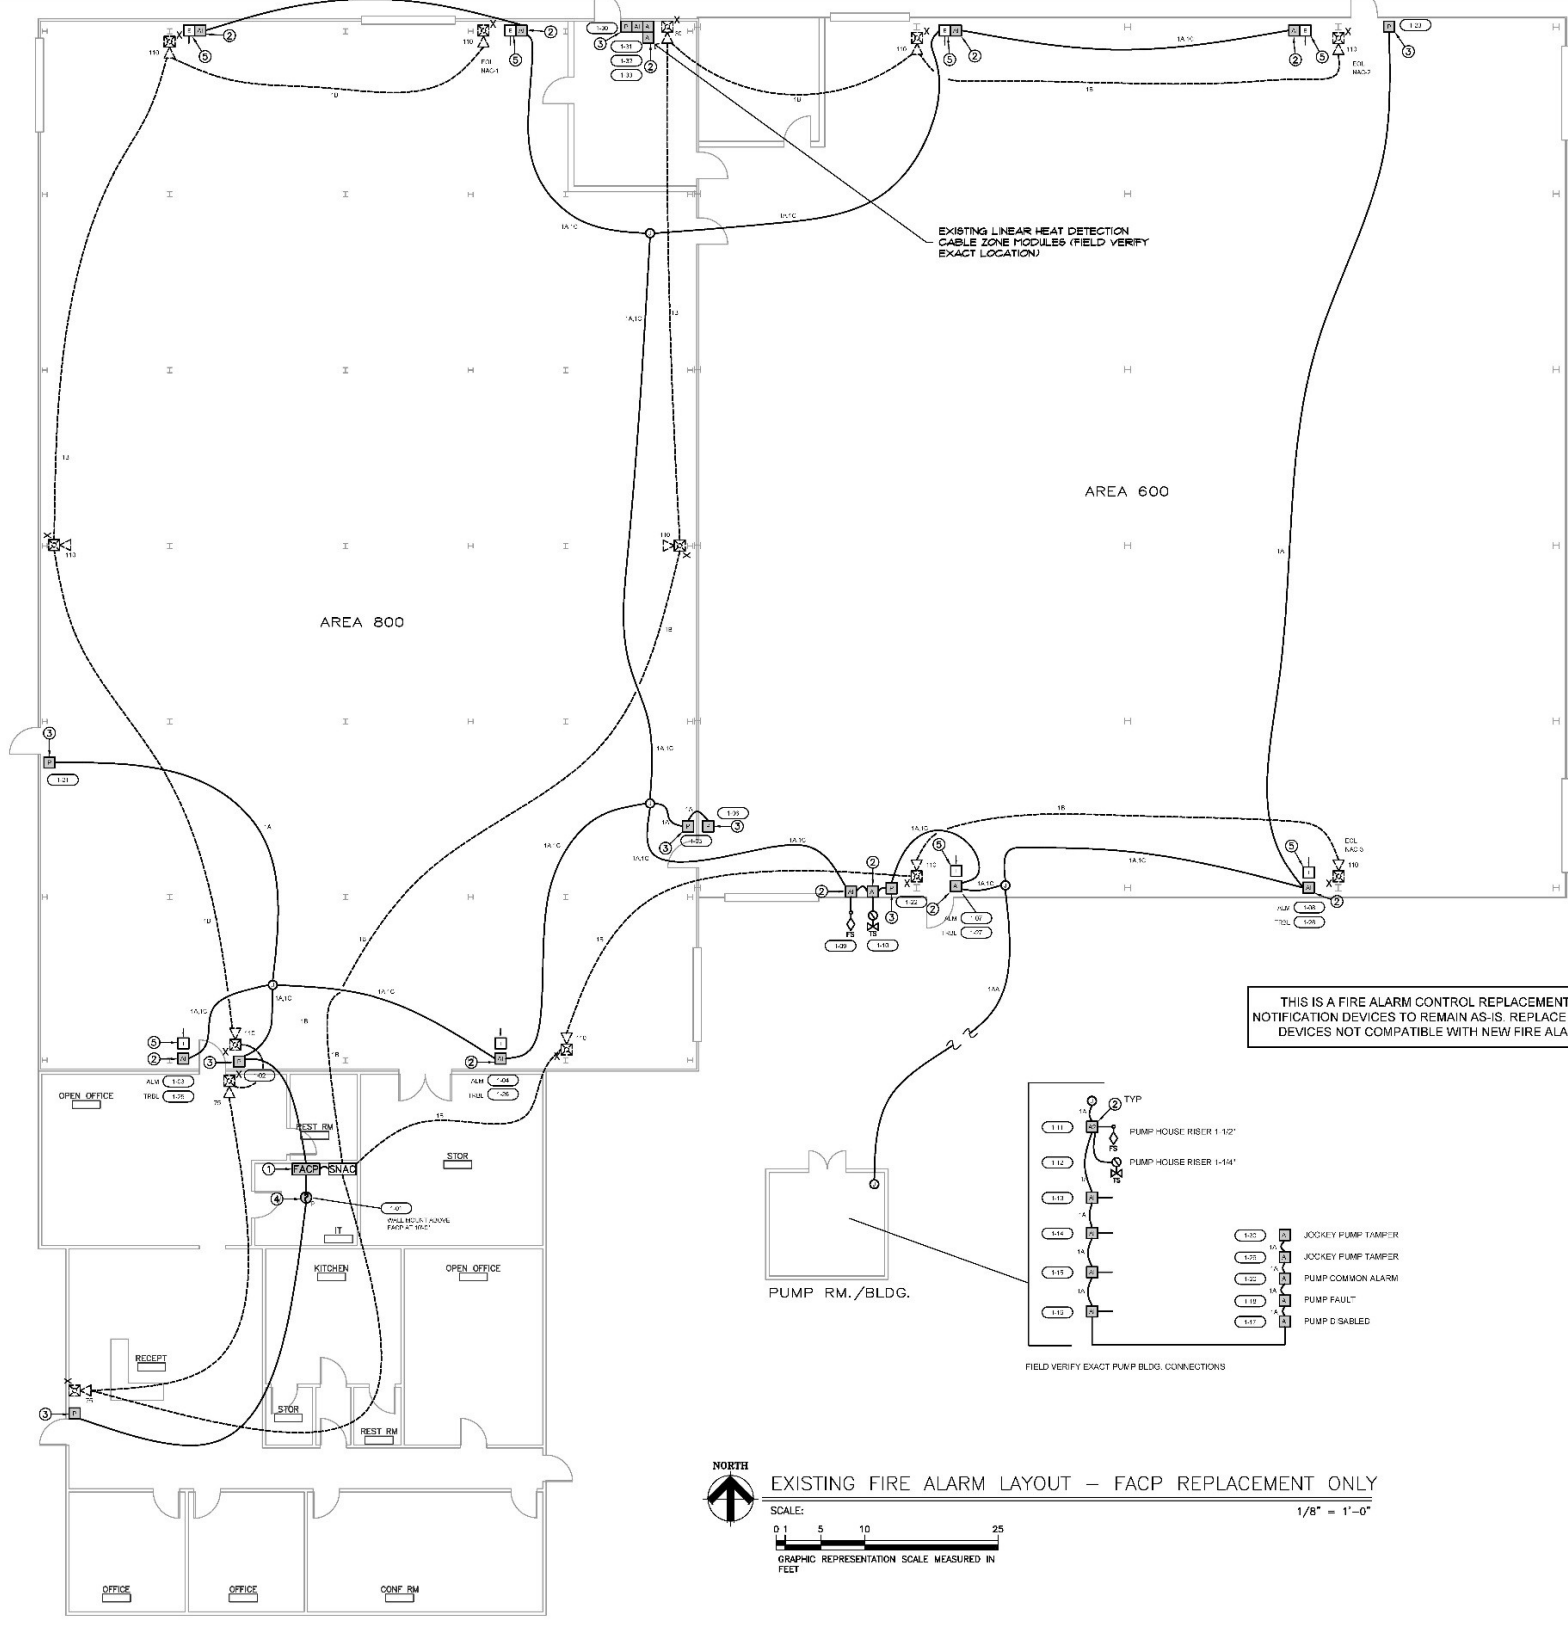

**KEY NOTE**

- 1 NEW FIRELITE MS-9200UDLS ADDRESSABLE FIRE ALARM CONTROL PANEL TO REPLACE THE EXISTING
- 2 REPLACE ALL EXISTING MONITOR MODULES COMPATIBLE WITH NEW FIRE ALARM CONTROL PANEL UTILIZING ALL EXISTING WIRING TYP. (FIELD VERIFY)
- 3 REPLACE ALL EXISTING FIRE ALARM REMOTE MANUAL PULL STATIONS TO BE COMPATIBLE WITH NEW FIRE ALARM CONTROL PANEL UTILIZING EXISTING WIRING TYP. (FIELD VERIFY EXACT LOCATION AND QTY)
- 4 REPLACE THE EXISTING FIRE ALARM SMOKE DETECTOR LOCATED ABOVE THE FIRE ALARM CONTROL PANEL TO BE COMPATIBLE WITH THE NEW FIRE ALARM CONTROL PANEL (FIELD VERIFY EXACT LOCATION)
- 5 EXISTING CONVENTIONAL BEAM SMOKE DETECTORS TO REMAIN AS-IS TIED-IN TO THE NEW FIRE ALARM CONTROL PANEL. PROVIDE A FIRE ALARM MONITOR MODULE IF REQUIRED FOR MONITORING (FIELD VERIFY)

**FIELD INSTALL NOTE**


TIE-IN NEW ADDRESSABLE MONITOR MODULES TO THE EXISTING SLC CIRCUIT ON FLOOR (FIELD VERIFY)

ALL EXISTING FIRE ALARM DEVICES SHOWN ON THE FIRE ALARM LAYOUT TO REMAIN AS-IS UNLESS NOTED OTHERWISE

WIRE SCHEDULE		
CODE	DESCRIPTION / FUNCTION	PART #
A	20#16 TW. JACKETED PAIR, SLC LOOP, MD-CAPACITANCE	BELDEN - 8220LL
B	20#14, HORN/STROBE OR NAC PROGR. CKT'S	BELDEN - 8120LL
C	20#16, POWER OR AUX. CONNECTION	BELDEN - 8220LL
D	20#16, MODULE INITIATION CKT.	BELDEN - 8220LL
E	20#18 TW. SH. PRL. SYSTEM BUS	BELDEN - 82841
AA	NET LOCATION, 20#18 TW. JACKETED PAIR, SLC LOOP	WEST PDM - A0225
CC	NET LOCATION, 20#16, POWER OR AUX. CONNECTION	WEST PDM - A0225
DD	NET LOCATION, 20#16, MODULE INITIATION CKT.	WEST PDM - A0225
EE	NET LOCATION, 20#18 TW. SH. PRL. SYSTEM BUS	WEST PDM - A0224

WIRING TO MEET NEC 780 STANDARDS

USE UNSHIELDED WIRE UNLESS OTHERWISE NOTED.  
 ALL SHIELDS MUST BE TIED THROUGH, ISOLATED, AND TERMINATED, IF USED.  
 PART NUMBERS SHOWN ARE FOR PLUMB RATED CABLES. IF IN CONFLICT OR IF NON-PLUMB CAN BE VERIFIED, PPL CABLE MAY BE USED IN PLACE OF PPL.  
 NOTE: NEC CIRCUIT WIRING HAS BEEN CALCULATED FOR VOLTAGE DROP AND CURRENT LOAD. CHANGING THE WIRING OR NUMBER OF DEVICES ON A CIRCUIT COULD RESULT IN OVERLOAD OR FAILURE OF CIRCUIT.

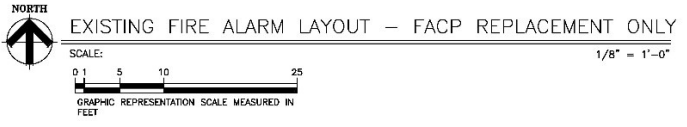

No.	Date	Description	Revisions

**A&J**  
 FIRE PROTECTION  
 P.O. BOX 82082  
 PHOENIX, ARIZONA 85071  
 OFFICE PHONE: (602) 546-7796  
 REF: C-18 28884

Reserved for Stamp  
 ENGINEERING TECHNICIAN  
 FIRE ALARM SYSTEMS  
 CERTIFICATION # 103985  
 N.I.C.E.T. III  
 VALID THRU 10/12/2019  
 ART CRUZ CET  
*Art Cruz*

Project Name and Address  
**HERITAGE ENVIRONMENTAL SERVICES, LLC**  
 284 EAST STOREY RD  
 COOLIDGE, AZ

Sheet Description  
**EXISTING FIRE ALARM LAYOUT - FACP REPLACEMENT ONLY**

Drawn AC  
 Job Number 17-004  
 Date 30, JANUARY 2017  
 Scale AS NOTED  
 Sheet Number **FA-2**

OF: TWO

ENGINEER SHALL NOT BE RESPONSIBLE FOR CONTRACTOR'S MEANS, METHODS, TECHNIQUES, SEQUENCES OR PROCEDURES OF CONSTRUCTION, OR THE SAFETY PRECAUTIONS AND PROGRAMS INCIDENT THEREIN, AND ENGINEER SHALL NOT BE RESPONSIBLE FOR CONTRACTOR'S FAILURE TO PERFORM THE WORK IN ACCORDANCE WITH THE CONTRACT DOCUMENTS

**ARCS**  
 DESIGN GROUP  
 ARCSdesigngroup.com  
 Phone: (623) 225-6005  
 email: cruz@ARCSdesigngroup.com  
 \*FOR ALL OF YOUR FIRE ALARM DESIGN NEEDS\*